
[illegible]



[illegible][illegible]

© Cardno Limited All Rights Reserved.
This document is produced by Cardno Limited solely for the
benefit of and use by the client in accordance with the
terms of the retainer. Cardno Limited does not and shall not
assume any responsibility or liability whatsoever to any third
party arising out of any use or reliance by third party on the
content of this document.



| | | | | | | | |
|---|--------------------|---------------------------------------|--|-------|--------------------|----------------|----------|
| Drawn D.MCKENZIE | Date 18.12.2018 | Client R&F GOLDEN PROPERTY PTY LTD | | | | | |
| Checked C.KEMPE | Date 27.03.2020 | Project | 309 PRIESTDALE ROAD, ROCHEDALE PRIESTDALE ROAD STAGE 1 CIVIL WORKS | | Status | AS CONSTRUCTED | |
| Designed L.KUSTERS | Date 18.12.2018 | Title | STORMWATER DRAINAGE | | Datum | AHD | |
| Verified L.GARSIDE | Date 18.12.2018 | | GRID | Scale | AS SHOWN | Size | A1 |
| Approved  | RPEQ: 19/06 | | Drawing Number | | 790468-001-CI-1312 | | Revision |
| J.O'SULLIVAN | Date 4/12/2020 | LONGITUDINAL SECTION - SHEET 2 | | | | | |

DATE PLOTTED: 10 December 2020 8:29 AM BY: J.O'SULLIVAN

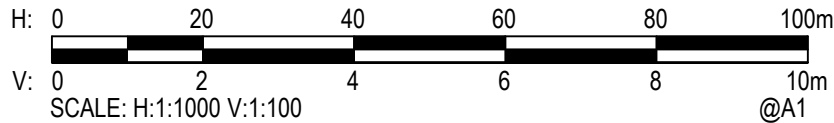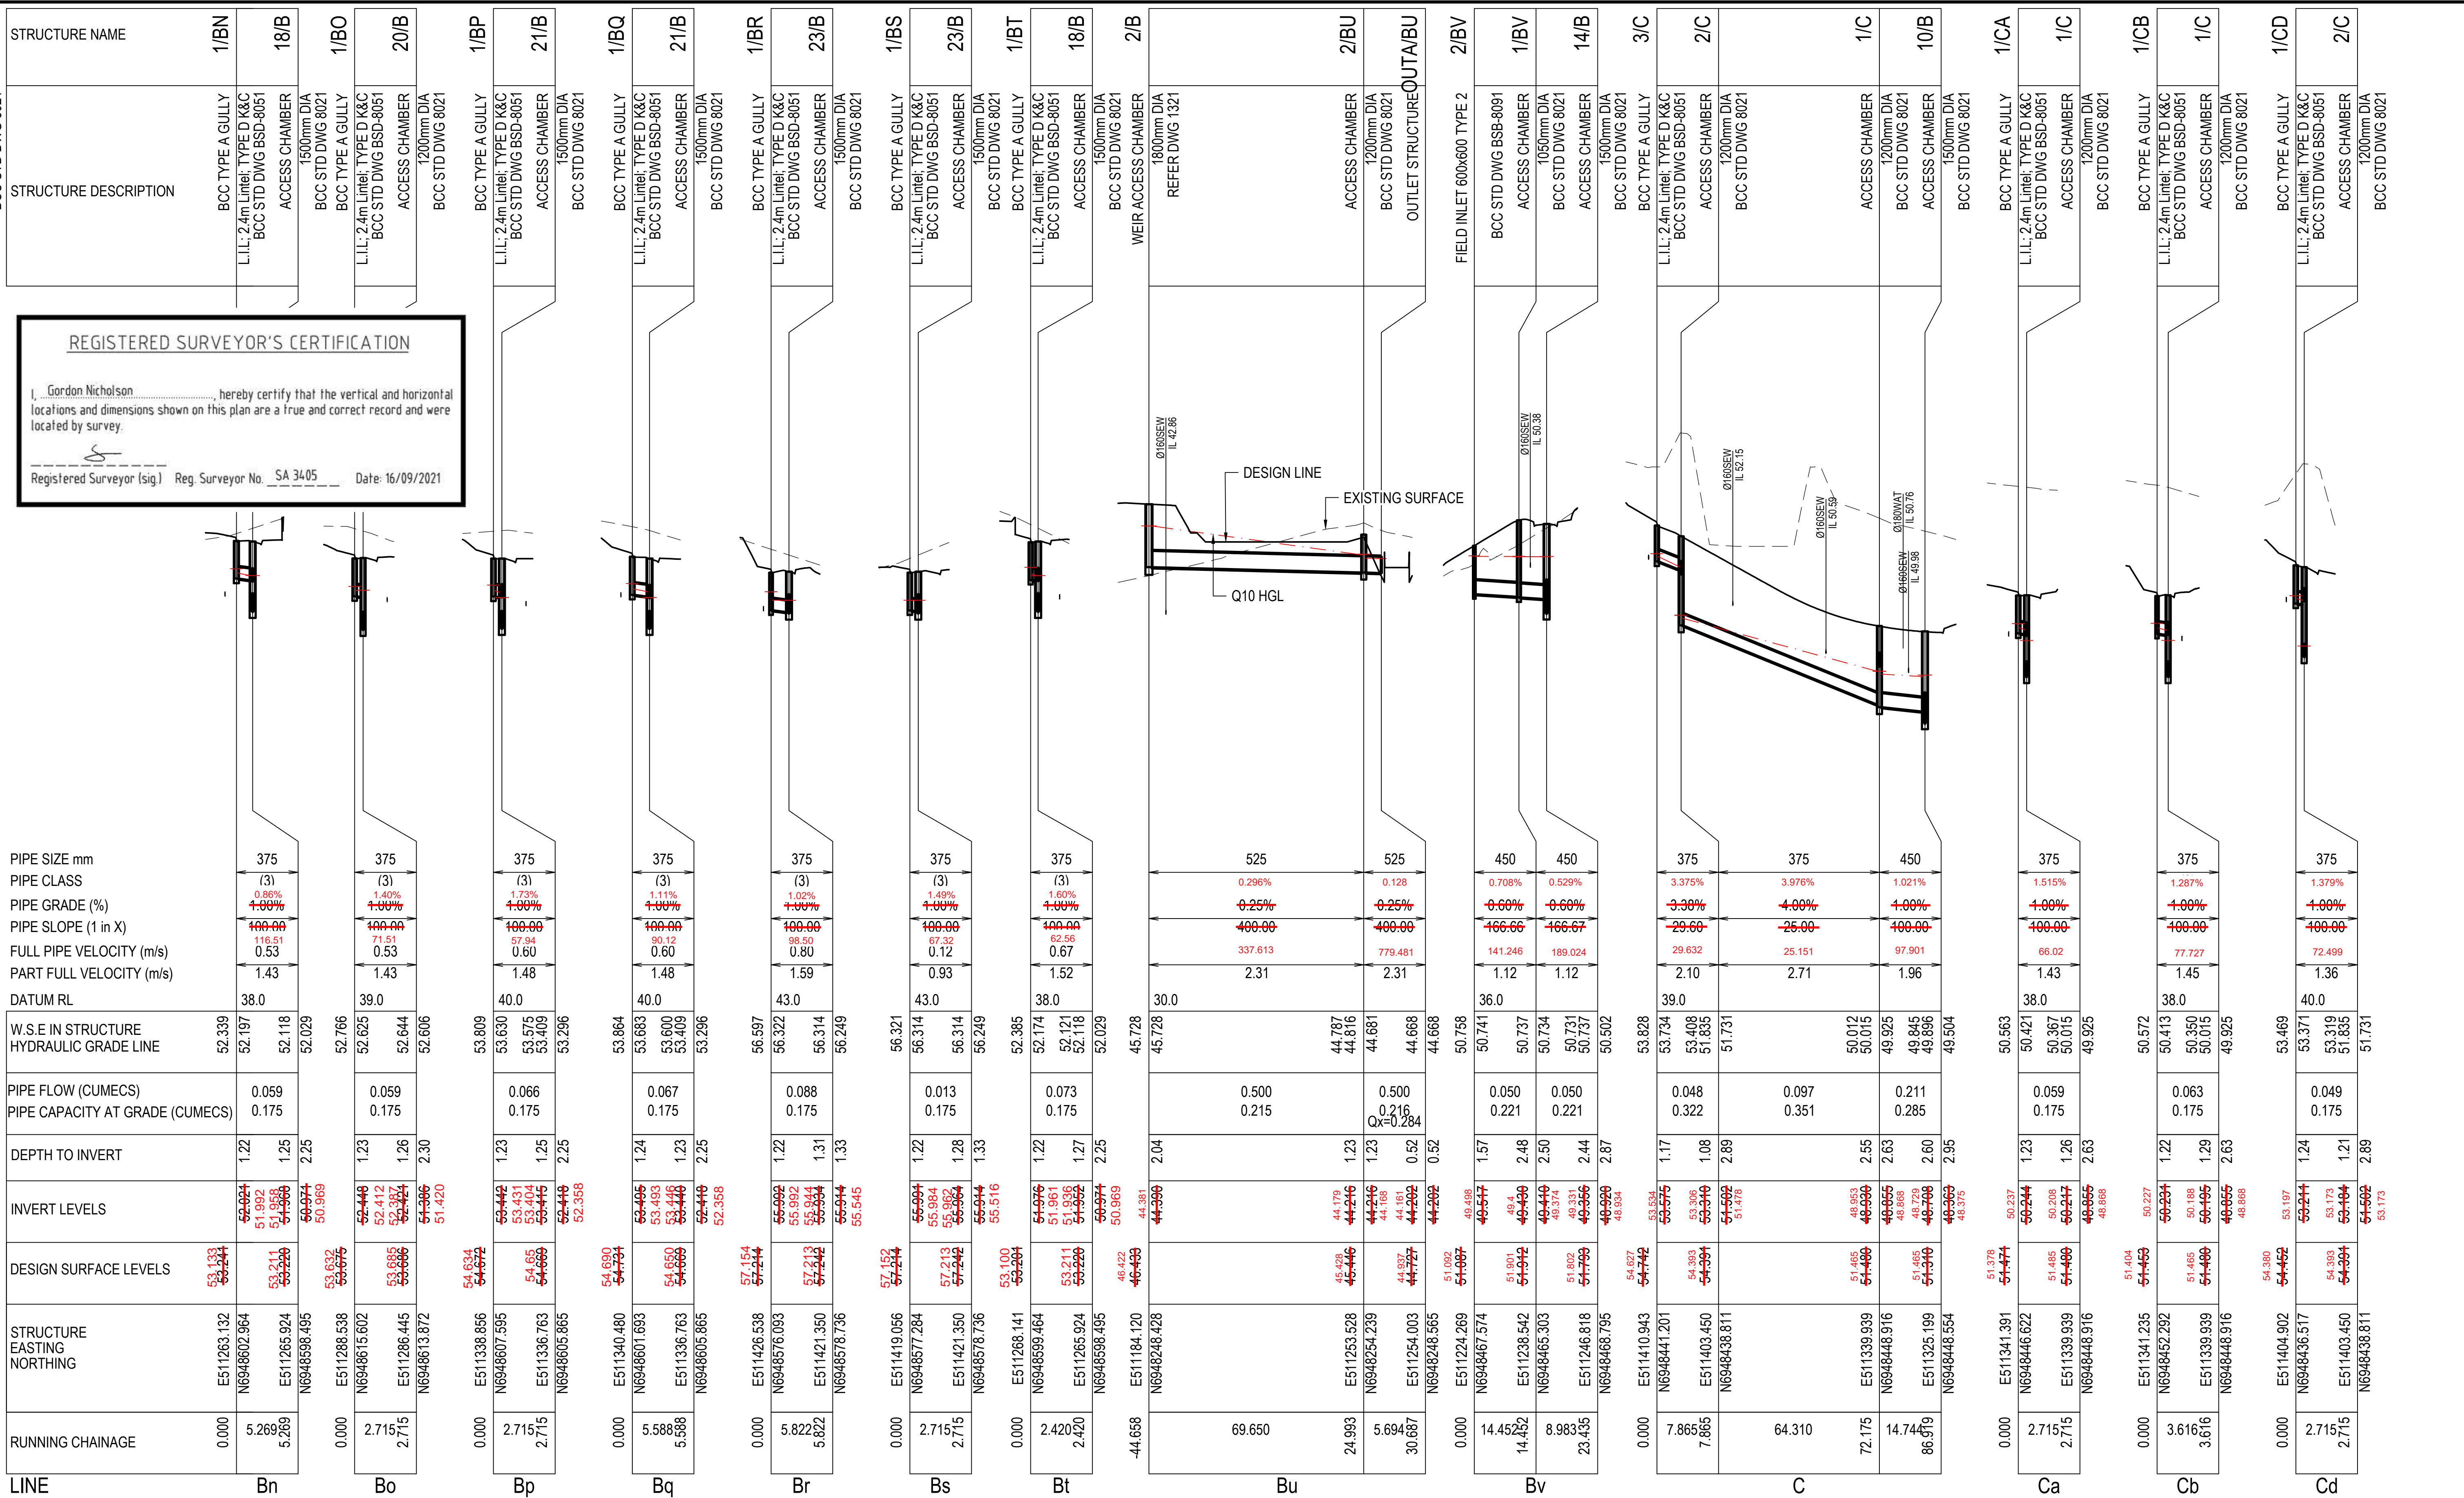

| | | | | | |
|------|------------|----------------------------------|------|--------|-------|
| | | | | | |
| B | 16/09/2021 | AS CONSTRUCTED | | | |
| A | 4/12/2020 | ISSUED FOR CONSTRUCTION | CK | JO'S | JO'S |
| 4 | 08.07.2020 | STORMWATER LONGSECTIONS UPDATED | BH | JO'S | JO'S |
| 3 | 13.05.2020 | OPERATIONAL WORKS APPROVAL ISSUE | CK | BW | JO |
| 2 | 17.04.2020 | UPDATED LAYOUT FOR APPROVAL | CK | BW | JO |
| 1 | 18.12.2018 | ISSUE FOR APPROVAL | DPM | LG | RB |
| Rev. | Date | Description | Des. | Verif. | Appd. |




© Cardno Limited All Rights Reserved.
This document is produced by Cardno Limited solely for the benefit of and use by the client in accordance with the terms of the retainer. Cardno Limited does not and shall not assume any responsibility or liability whatsoever to any third party arising out of any use or reliance by third party on the content of this document.



| | | | |
|----------|--------------|------|------------|
| Drawn | D.MCKENZIE | Date | 18.12.2018 |
| Checked | C.KEMPE | Date | 27.03.2020 |
| Designed | L.KUSTERS | Date | 18.12.2018 |
| Verified | L.GARSDIE | Date | 18.12.2018 |
| Approved | J.O'SULLIVAN | Date | 4/12/2020 |

| | |
|---------|---------------------------------|
| Client | R&F GOLDEN PROPERTY PTY LTD |
| Project | 309 PRIESTDALE ROAD, ROCHE DALE |
| | PRIESTDALE ROAD STAGE 1 |
| | CIVIL WORKS |
| Title | STORMWATER DRAINAGE |
| | LONGITUDINAL SECTION - SHEET 3 |

| | | | | | | |
|--------------------|-----|----------------|-------|----------|----------|-----|
| Status | | AS CONSTRUCTED | | | | |
| Datum | AHD | GRID | Scale | AS SHOWN | Size | A1 |
| Drawing Number | | | | | Revision | B A |
| 790468-001-CI-1313 | | | | | | |

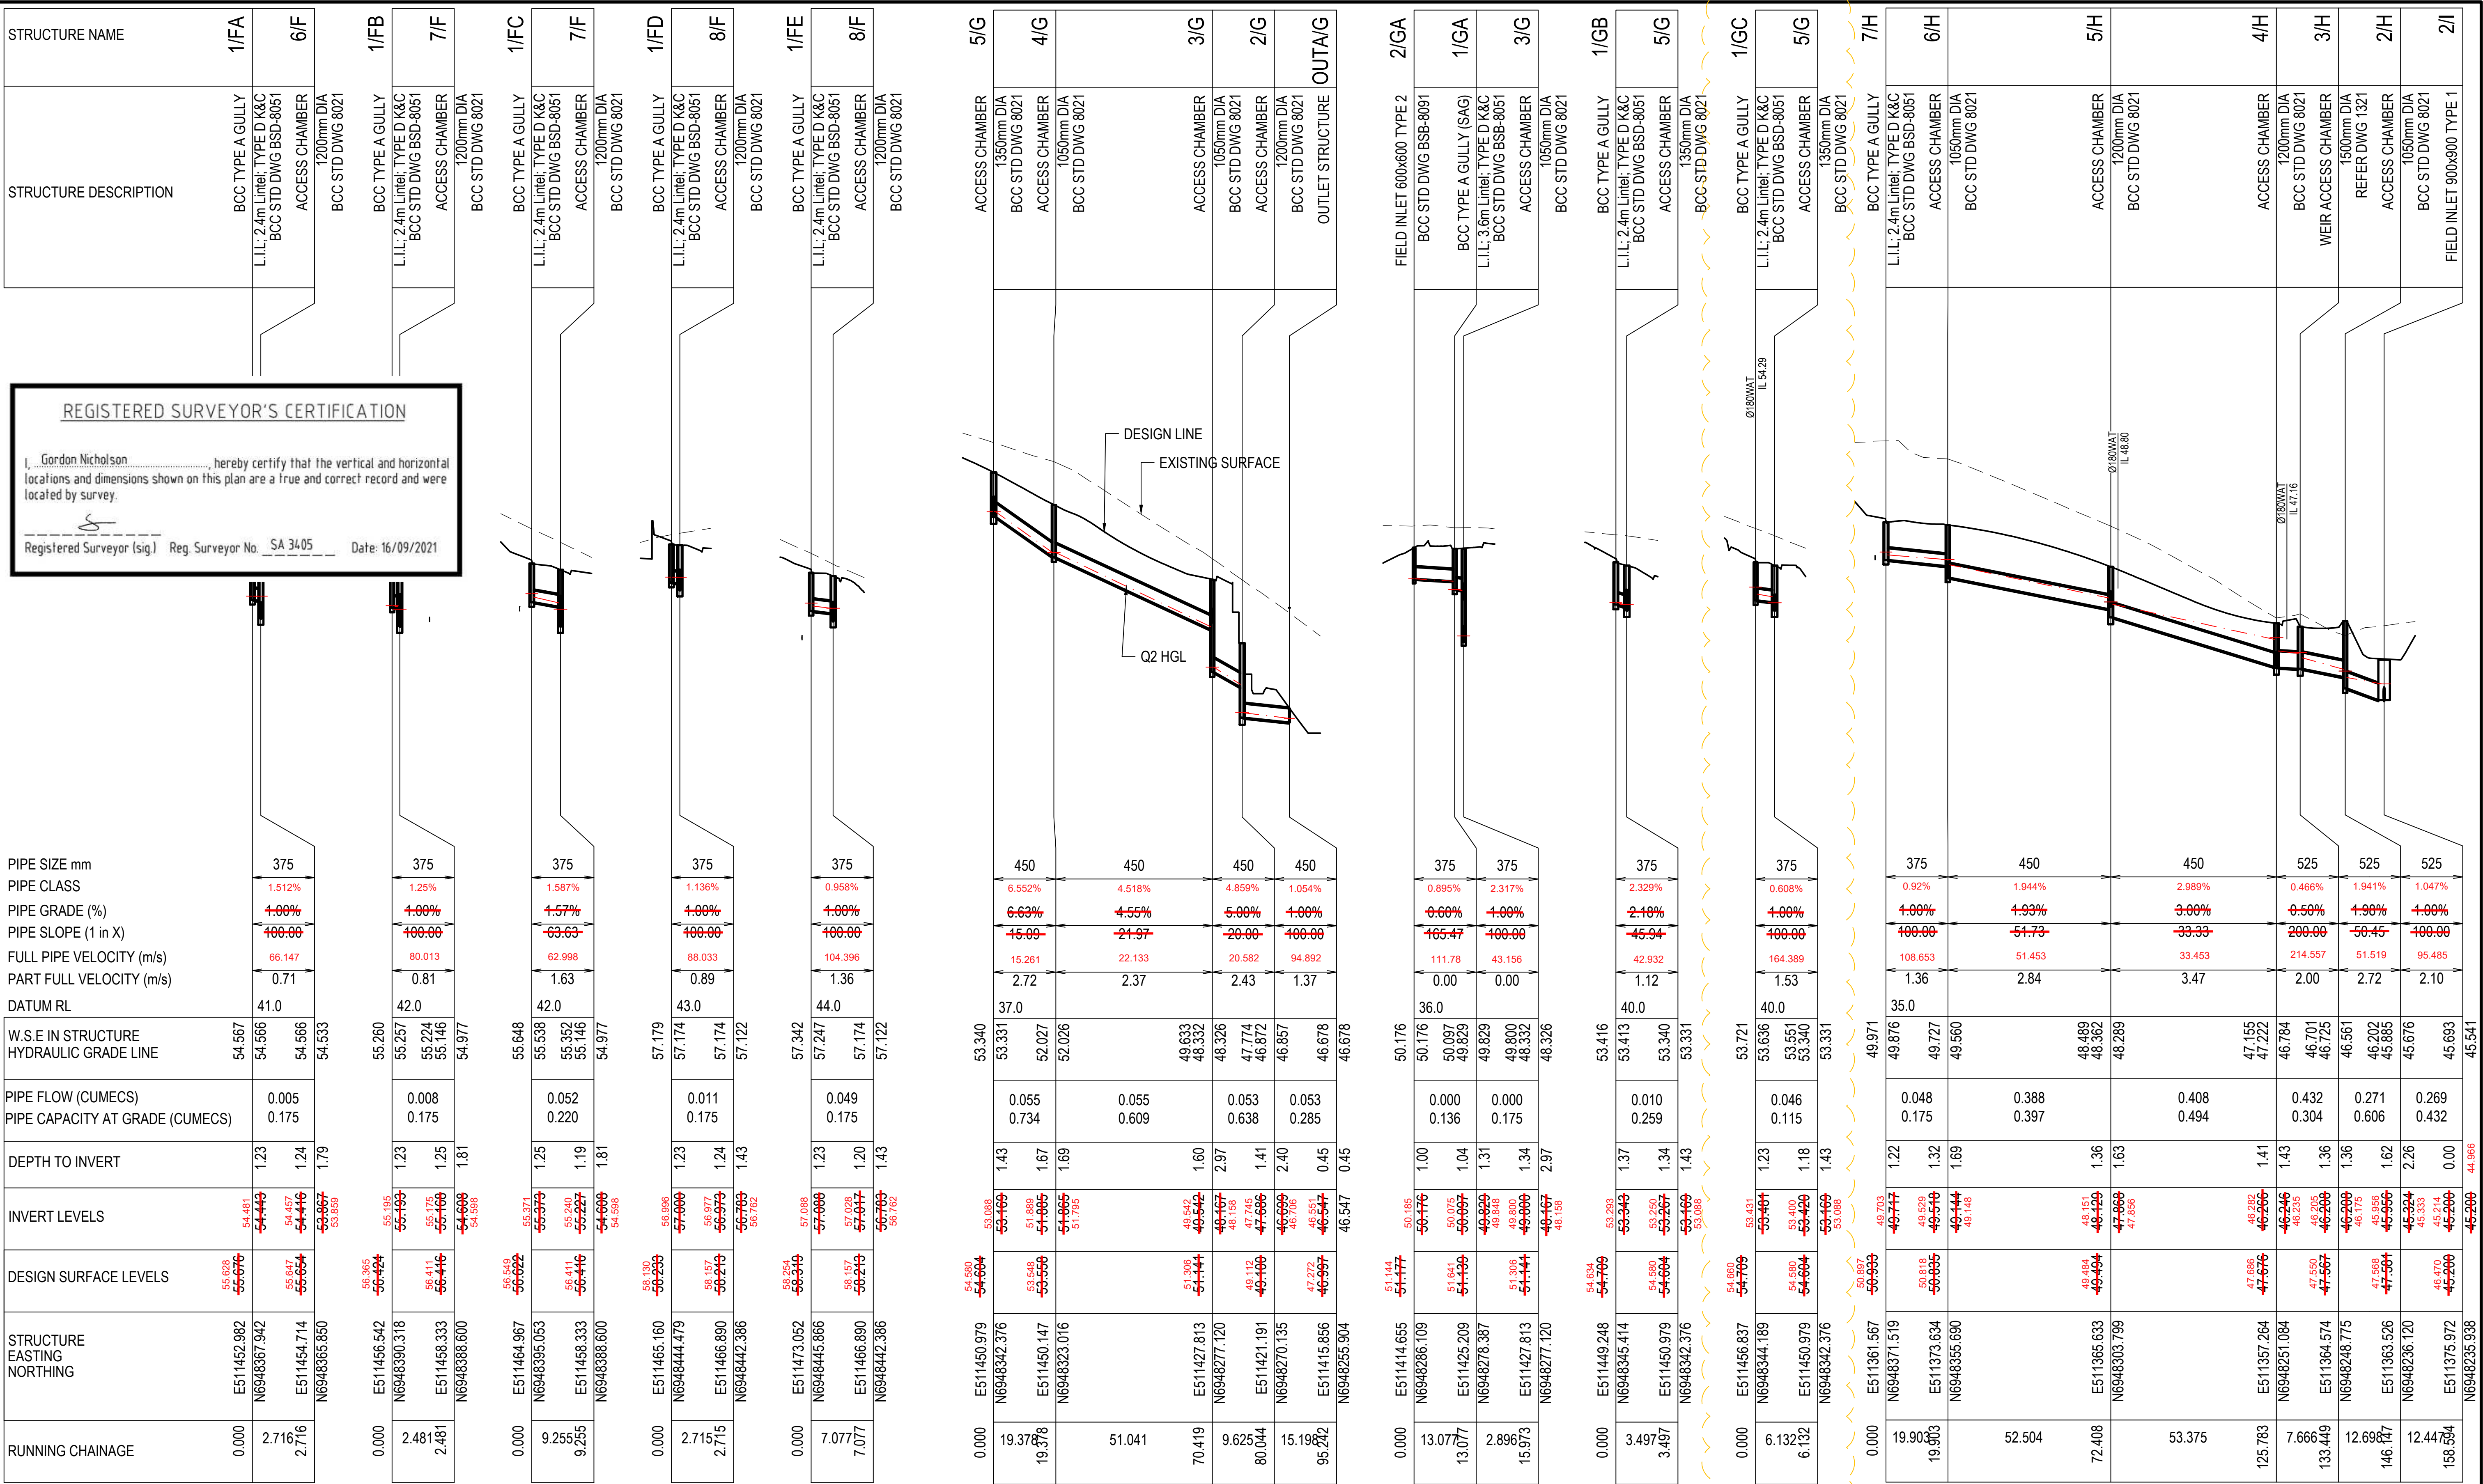

| | | | | | |
|------|------------|----------------------------------|------|--------|-------|
| C | 16/09/2021 | AS CONSTRUCTED | | | |
| B | 2/03/2021 | LINE Gc ADDED | CK | JO'S | JO'S |
| A | 4/12/2020 | ISSUED FOR CONSTRUCTION | CK | JO'S | JO'S |
| 6 | 17.09.2020 | STORMWATER LINES AMENDED | BJF | JO'S | JO'S |
| 5 | 09.09.2020 | STORMWATER LINES AMENDED | BJF | JO'S | JO'S |
| 4 | 08.07.2020 | STORMWATER LONGSECTIONS UPDATED | BH | JO'S | JO'S |
| 3 | 13.05.2020 | OPERATIONAL WORKS APPROVAL ISSUE | CK | BW | JO |
| 2 | 17.04.2020 | UPDATED LAYOUT FOR APPROVAL | CK | BW | JO |
| 1 | 18.12.2018 | ISSUE FOR APPROVAL | DPM | LG | RB |
| Rev. | Date | Description | Des. | Verif. | Appd. |




© Cardno Limited All Rights Reserved.
This document is produced by Cardno Limited solely for the benefit of and use by the client in accordance with the terms of the retainer. Cardno Limited does not and shall not assume any responsibility or liability whatsoever to any third party arising out of any use or reliance by third party on the content of this document.



Cardno (Qld) Pty Ltd | ABN 57 051 074 992
Level 6, Springfield Tower, 145 Sinnamahy Boulevard
Springfield Central QLD 4300
Tel: 07 3381 0111 Fax: 07 3470 1241
Web: www.cardno.com.au

| | | |
|--------------------------|--------------------|---|
| Drawn D.MCKENZIE | Date 18.12.2018 | Client R&F GOLDEN PROPERTY PTY LTD |
| Checked C.KEMPE | Date 27.03.2020 | Project 309 PRIESTDALE ROAD, ROCHEDALE |
| Designed L.KUSTERS | Date 18.12.2018 | PRIESTDALE ROAD STAGE 1 |
| Verified L.GARSDIE | Date 18.12.2018 | CIVIL WORKS |
| Approved J.O'SULLIVAN | Date 4/12/2020 | STORMWATER DRAINAGE |
| | | Title LONGITUDINAL SECTION - SHEET 5 |
| | | Status AS CONSTRUCTED |
| | | Datum AHD |
| | | Grid AS SHOWN |
| | | Scale AS SHOWN |
| | | Size A1 |
| | | Drawing Number 790468-001-CI-1315 |
| | | Revision C |

| STRUCTURE NAME | 2/HA | 1/HA | 4/H | 1/HAA | 1/HA | 3/H | 2/HC | 1/HC | 5/H | 1/HD | 5/H | 2/I | OUTA/I | 3/J | 2/J | OUTA/J | 1/K | 2/J | 9/P | 8/P | 7/P | 6/P | 5/P | 4/P | 3/P | 2/P | OUTA/P | |
|--|---|--|--|--|--|---|-----------------------------|--|--|--|--|-----------------------------|-----------------------------|-----------------------------|---|-----------------------------|--|---|--|--|--|---|--|--|--|--|------------------|--|
| STRUCTURE DESCRIPTION | BCC TYPE A GULLY (SAG) L.I.L.: 2.4m Linel; TYPE D K&C BCC STD DWG BSB-8051 | ACCESS CHAMBER 1200mm DIA BCC STD DWG 8021 | ACCESS CHAMBER 1200mm DIA BCC STD DWG 8021 | BCC TYPE A GULLY (SAG) L.I.L.: 2.4m Linel; TYPE D K&C BCC STD DWG BSB-8051 | ACCESS CHAMBER 1200mm DIA BCC STD DWG 8021 | WEIR ACCESS CHAMBER 1500mm DIA REFER DWG 1321 | FIELD INLET 600x600 TYPE 2 | BCC STD DWG BSB-8091 BCC TYPE A GULLY L.I.L.: 2.4m Linel; TYPE D K&C BCC STD DWG BSD-8051 | ACCESS CHAMBER 1200mm DIA BCC STD DWG 8021 | BCC TYPE A GULLY L.I.L.: 2.4m Linel; TYPE D K&C BCC STD DWG BSD-8051 | ACCESS CHAMBER 1200mm DIA BCC STD DWG 8021 | FIELD INLET 900x900 TYPE 1 | OUTLET STRUCTURE | FIELD INLET 900x900 TYPE 1 | BCC STD DWG BSB-8091 CUSTOM CHAMBER 2250x3000mm REFER DWG 1321 | OUTLET STRUCTURE | FIELD INLET 900x900 TYPE 1 1200mm DIA BCC STD DWG BSB-8091 | CUSTOM CHAMBER 2250x3000mm REFER DWG 1321 | BCC TYPE A GULLY (SAG) L.I.L.: 3.6m Linel; TYPE D K&C BCC STD DWG BSB-8051 | BCC TYPE A GULLY L.I.L.: 2.4m Linel; TYPE D K&C BCC STD DWG BSD-8051 | ACCESS CHAMBER 1200mm DIA BCC STD DWG 8021 | FIELD INLET 900x900 TYPE 1 OVER 1200mm DIA | ACCESS CHAMBER 1050mm DIA BCC STD DWG 8021 | ACCESS CHAMBER 1050mm DIA BCC STD DWG 8021 | ACCESS CHAMBER 1200mm DIA BCC STD DWG 8021 | ACCESS CHAMBER 1200mm DIA BCC STD DWG 8021 | OUTLET STRUCTURE | |
| REGISTERED SURVEYOR'S CERTIFICATION | <div><div>I, <u>Gordon Nicholson</u>, hereby certify that the vertical and horizontal locations and dimensions shown on this plan are a true and correct record and were located by survey.</div><div><div></div><div>Registered Surveyor (sig.)</div><div>Reg. Surveyor No. <u>SA 3405</u></div><div>Date: <u>16/09/2021</u></div></div></div> | | | PIPE SIZE mm | 375 | 375 | | 375 | | 375 | 375 | 375 | 375 | 375 | 375 | 375 | 375 | 450 | (2x)375 | | (2x)450 | 525 | 525 | 450 | 450 | 450 | 450 | 525 | 525 | 525 | | |
| PIPE CLASS | 0.996% | 0.948% | | 1.048% | | 0.521% | 0.595% | 1.892% | 0.964% | 0.591% | 0.591% | 0.591% | 0.591% | 0.310% | 0.728% | | 0.607% | (3) | (3) | 4.77% | 7.092% | 0.533% | 7.210% | 0.518% | 0.422% | | | |
| PIPE GRADE (%) | 1.00% | 1.00% | | 1.00% | | 0.50% | 0.89% | 1.59% | 0.89% | 0.58% | 0.58% | 0.58% | 0.58% | 0.30% | 0.40% | | 0.50% | 2.00% | 2.50% | 4.75% | 7.00% | 7.00% | 0.50% | 0.50% | 0.51% | | | |
| PIPE SLOPE (1 in X) | 100.00 | 100.00 | | 100.00 | | 200.00 | 111.75 | 62.80 | 100.00 | 171.04 | 169.336 | 171.04 | 171.04 | 333.33 | 208.51 | | 200.00 | 50.00 | 40.00 | 21.05 | 14.29 | 14.29 | 200.00 | 200.00 | 194.30 | | | |
| FULL PIPE VELOCITY (m/s) | 100.431 | 105.485 | | 95.396 | | 191.937 | 167.965 | 52.851 | 103.698 | 169.336 | 169.336 | 169.336 | 169.336 | 322.807 | 137.323 | | 164.772 | 0.93 | 0.97 | 20.964 | 14.100 | 13.870 | 13.870 | 192.916 | 237.208 | | | |
| PART FULL VELOCITY (m/s) | 1.03 | 1.26 | | 1.04 | | 1.45 | 0.00 | 1.09 | 1.06 | 2.42 | 0.00 | 2.42 | 2.42 | 0.00 | 5.73 | | 1.88 | 2.52 | 2.77 | 3.52 | 4.05 | 4.04 | 1.51 | 1.51 | 1.52 | | | |
| DATUM RL | 33.0 | | | 33.0 | | 33.0 | 35.0 | 32.0 | 35.0 | 32.0 | 32.0 | 32.0 | 32.0 | 29.0 | 42.974 | | 30.0 | 36.0 | 36.0 | 36.0 | 36.0 | 36.0 | 36.0 | 36.0 | 36.0 | | | |
| W.S.E IN STRUCTURE HYDRAULIC GRADE LINE | 47.014 | 47.000 | 47.000 | 47.015 | 47.000 | 46.531 | 48.606 | 45.541 | 48.462 | 45.484 | 45.484 | 45.693 | 45.541 | 44.189 | 43.679 | 42.974 | 44.786 | 44.374 | 52.389 | 52.317 | 52.216 | 48.758 | 47.840 | 45.638 | 45.512 | 45.426 | | |
| PIPE FLOW (CUMECS) | | 0.019 | 0.038 | 0.019 | | 0.160 | 0.000 | 0.267 | 0.020 | 0.267 | 0.135 | 0.000 | 0.135 | 0.000 | 1.265 | 0.243 | 0.597 | 0.201 | 0.210 | 0.209 | 0.207 | 0.207 | 0.206 | 0.205 | 0.204 | | | |
| PIPE CAPACITY AT GRADE (CUMECS) | 0.175 | 0.175 | | 0.175 | | 0.124 | 0.166 | 0.135 | 0.175 | 0.135 | 0.135 | 0.166 | 0.135 | 0.156 | 0.243 | 0.309 | 0.403 | 0.608 | 0.680 | 0.622 | 0.755 | 0.755 | 0.304 | 0.304 | 0.309 | | | |
| DEPTH TO INVERT | 1.11 | 1.20 | 1.26 | 1.14 | 1.24 | 1.26 | 1.11 | 1.35 | 1.23 | 0.63 | 0.63 | 1.42 | 1.42 | 1.50 | 1.52 | 1.34 | 2.76 | 1.50 | 1.44 | 1.61 | 1.63 | 1.76 | 2.41 | 2.25 | 2.84 | 0.60 | | |
| INVERT LEVELS | 46.470 46.470 | 46.445 46.446 | 46.399 46.399 | 46.452 46.445 | 46.409 46.409 | 46.388 46.388 | 48.546 48.546 | 44.956 44.956 | 48.323 48.323 | 44.880 44.880 | 47.894 47.894 | 45.693 45.693 | 44.956 44.956 | 42.705 42.705 | 42.683 42.683 | 42.974 42.974 | 42.786 42.786 | 42.705 42.705 | 52.088 51.927 | 51.907 51.907 | 51.682 51.649 | 46.607 46.607 | 46.558 46.558 | 45.512 45.512 | 45.426 45.426 | 45.365 45.365 | | |
| DESIGN SURFACE LEVELS | 47.544 47.504 | 47.653 47.646 | 47.696 47.676 | 47.545 47.599 | 47.653 47.646 | 47.775 47.764 | 49.714 49.714 | 45.480 45.506 | 47.856 47.856 | 44.880 44.880 | 46.470 46.470 | 46.300 46.300 | 44.956 44.956 | 44.200 44.200 | 43.995 43.995 | 42.974 42.974 | 42.545 42.545 | 44.906 44.906 | 53.530 53.534 | 53.089 53.089 | 51.254 51.254 | 47.643 47.643 | 48.114 48.114 | 48.092 48.092 | 45.814 45.814 | 45.660 45.660 | | |
| STRUCTURE EASTING NORTHING | E511358.418 N6948244.402 | E511356.646 N6948247.193 | E511357.264 N6948251.084 | E511352.764 N6948245.300 | E511356.646 N6948247.193 | E511364.580 N6948248.626 | E511373.246 N6948305.748 | E511363.196 N6948305.985 | E511365.633 N6948303.799 | E511375.972 N6948235.938 | E511375.631 N6948223.971 | E511375.972 N6948235.938 | E511375.631 N6948223.971 | E511259.673 N6948239.546 | E511232.376 N6948238.457 | E511233.801 N6948221.210 | E511227.919 N6948254.783 | E511232.376 N6948238.457 | E511459.810 N6948316.525 | E511450.994 N6948318.453 | E511430.756 N6948276.865 | E511424.797 N6948267.805 | E511421.810 N6948260.615 | E511418.590 N6948239.161 | E511397.727 N6948237.149 | E511397.438 N6948226.771 | | |
| RUNNING CHAINAGE | 0.000 | 3.306 | 3.940 | 0.000 | 4.320 | 1.602 | -5.056 | 0.000 | 4.744 | 0.000 | 11.973 | 0.000 | 11.973 | 0.000 | 27.319 | 44.625 | 0.000 | 16.923 | 8.027 | 9.025 | 17.052 | 46.250 | 10.844 | 21.696 | 20.960 | 10.388 | | |
| LINE | Ha | | | Haa | | Hb | Hc | | Hd | I | J | | | K | | | | | | P | | | | | | | | |

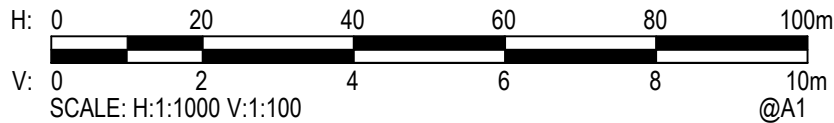

| | | | | | |
|------|------------|----------------------------------|------|--------|-------|
| B | 16/09/2021 | AS CONSTRUCTED | | | |
| A | 4/12/2020 | ISSUED FOR CONSTRUCTION | CK | JO'S | JO'S |
| 4 | 09.09.2020 | STORMWATER LINES AMENDED | BJF | JO'S | JO'S |
| 3 | 08.07.2020 | STORMWATER LONGSECTIONS UPDATED | BH | JO'S | JO'S |
| 2 | 13.05.2020 | OPERATIONAL WORKS APPROVAL ISSUE | CK | BW | JO |
| 1 | 17.04.2020 | ISSUE FOR APPROVAL | CK | BW | JO |
| Rev. | Date | Description | Des. | Verif. | Appd. |



© Cardno Limited All Rights Reserved.
This document is produced by Cardno Limited solely for the benefit of and use by the client in accordance with the terms of the retainer. Cardno Limited does not and shall not assume any responsibility or liability whatsoever to any third party arising out of any use or reliance by third party on the content of this document.



| | | | |
|----------|--------------|------|------------|
| Drawn | D.MCKENZIE | Date | 18.12.2018 |
| Checked | C.KEMPE | Date | 27.03.2020 |
| Designed | L.KUSTERS | Date | 18.12.2018 |
| Verified | L.GARSDIE | Date | 18.12.2018 |
| Approved | J.O'SULLIVAN | Date | 4/12/2020 |

| | |
|---------|---------------------------------|
| Client | R&F GOLDEN PROPERTY PTY LTD |
| Project | 309 PRIESTDALE ROAD, ROCHE DALE |
| | PRIESTDALE ROAD STAGE 1 |
| | CIVIL WORKS |
| Title | STORMWATER DRAINAGE |
| | LONGITUDINAL SECTION - SHEET 6 |

| | | | | | |
|--------------------|----------------|-------|----------|----------|--|
| Status | AS CONSTRUCTED | | | | |
| Datum | GRID | Scale | Size | A1 | |
| AHD | | | AS SHOWN | | |
| Drawing Number | | | | Revision | |
| 790468-001-CI-1316 | | | | B A | |