



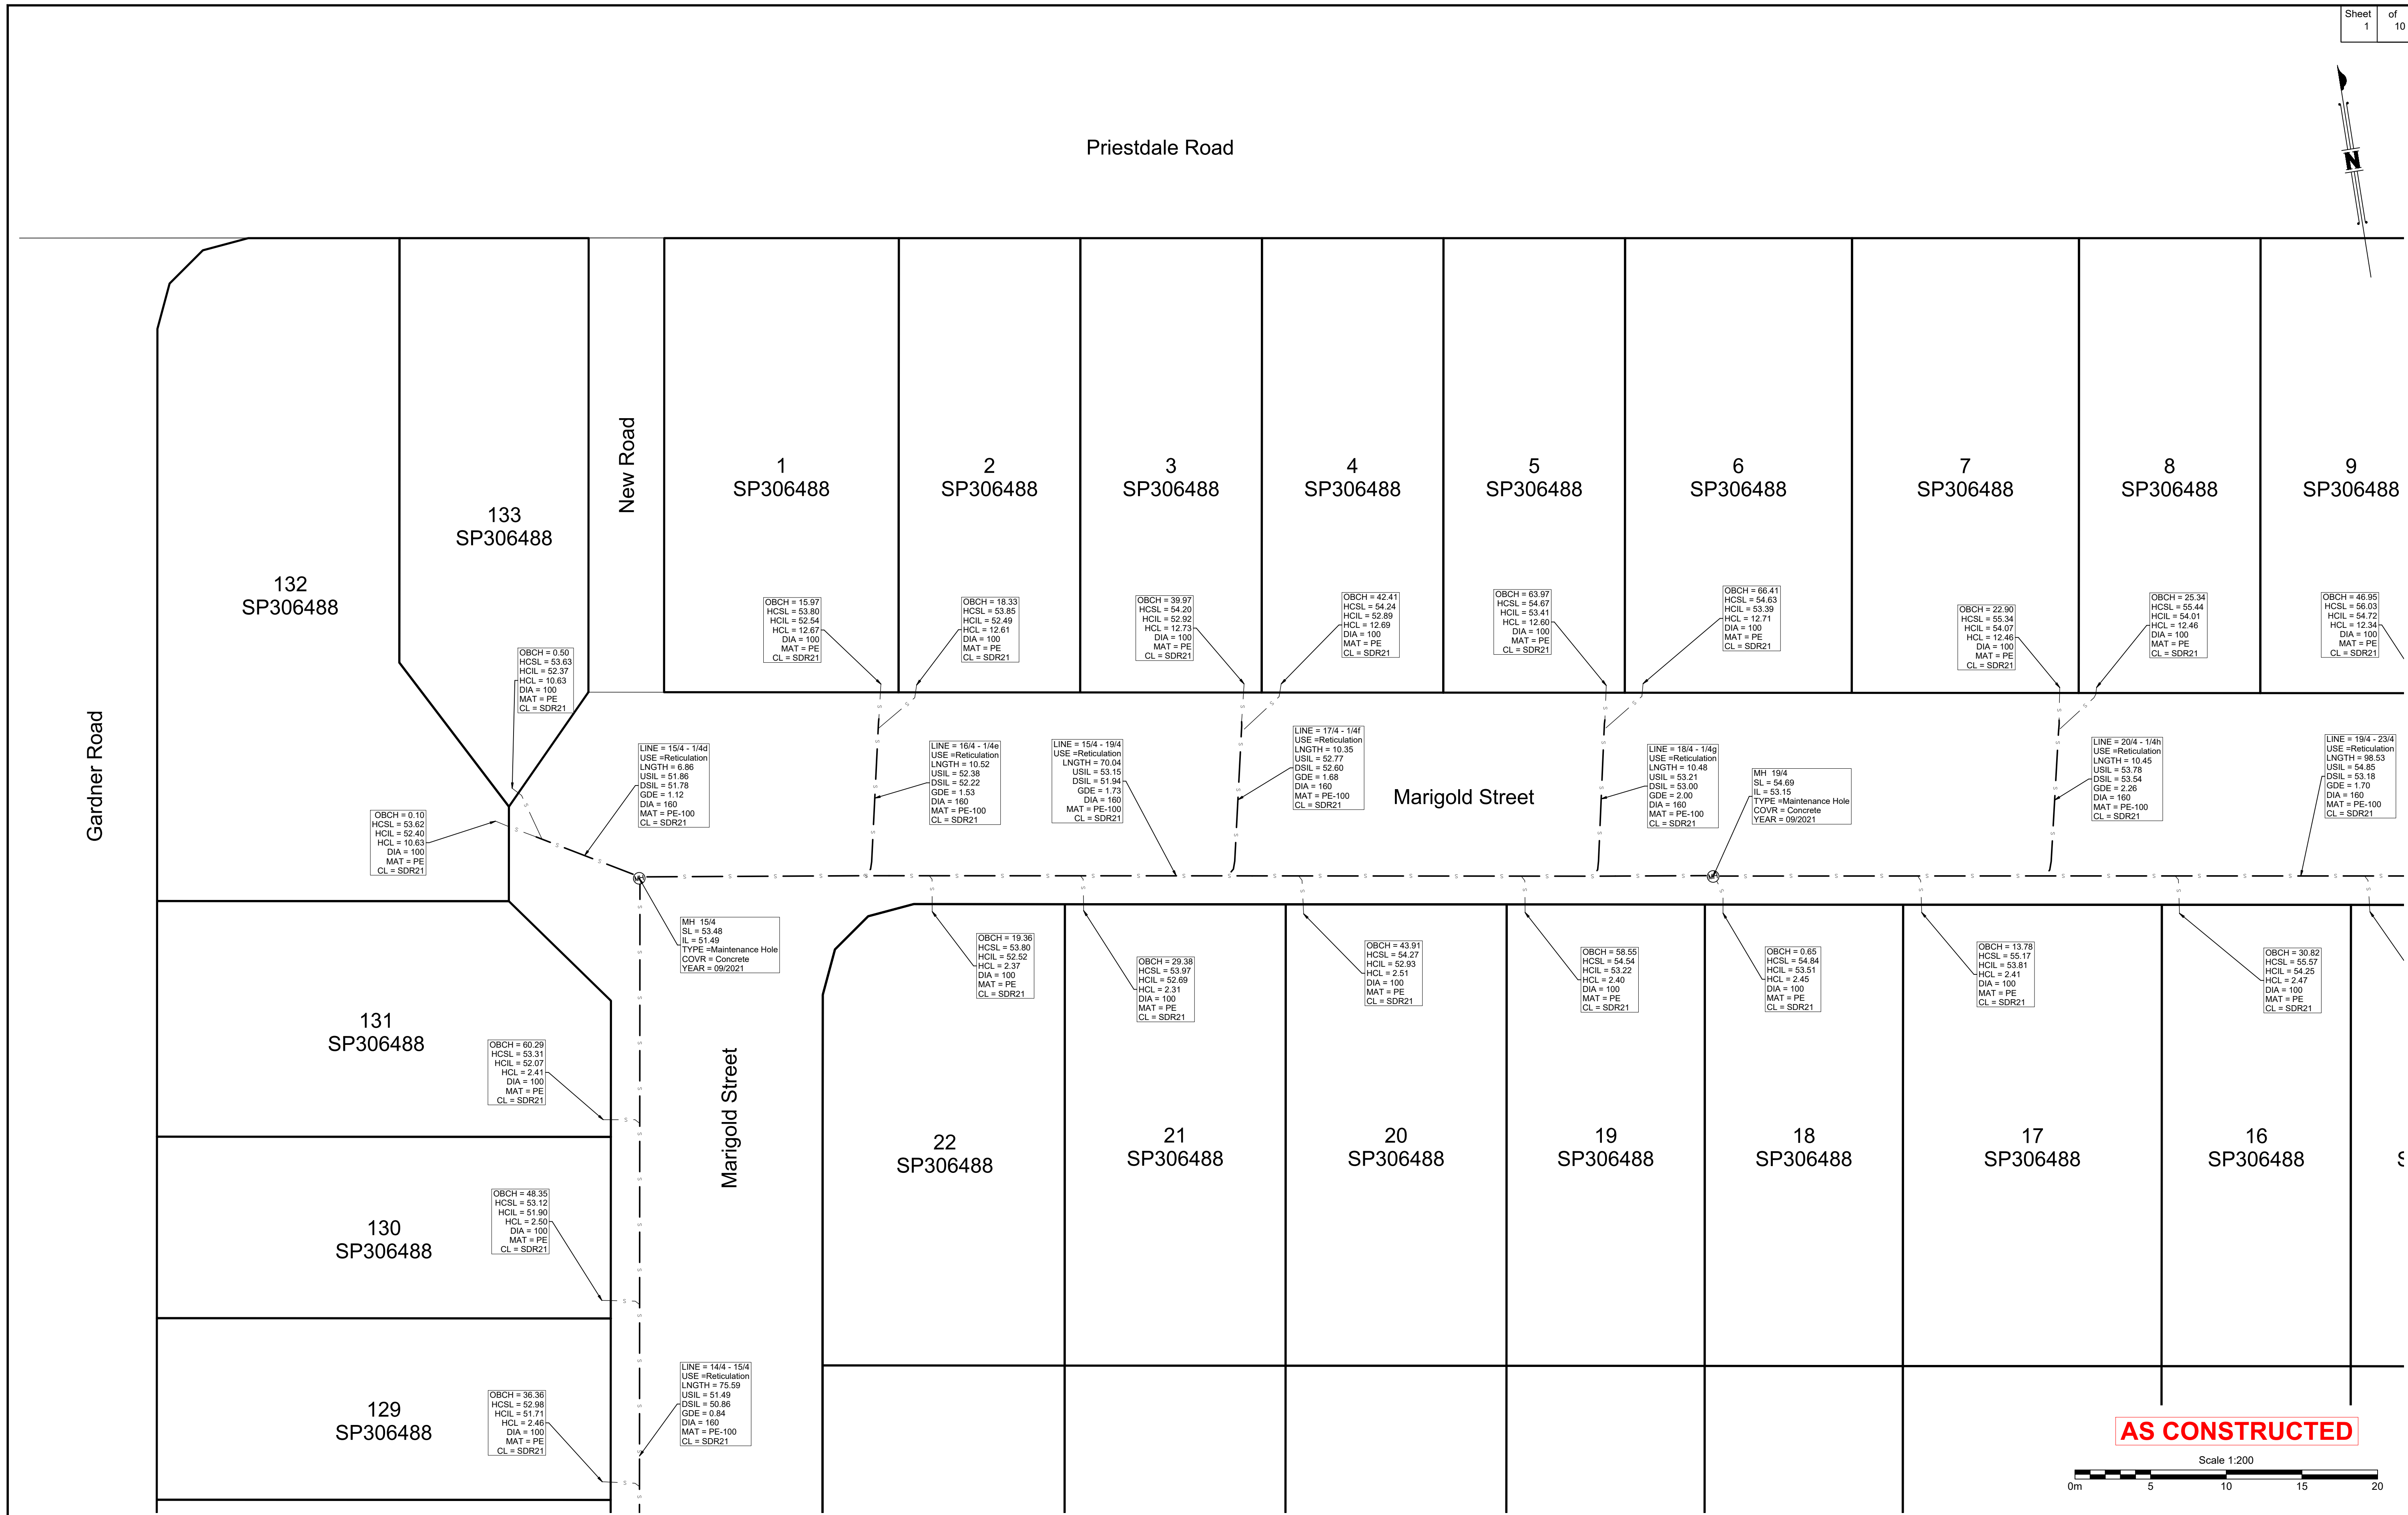

AS CONSTRUCTED

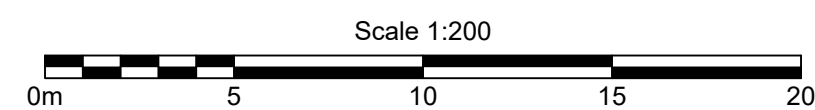

B.B.H PTY. LTD ABN 010 427 531
(trading as Bennett and Bennett Group) hereby certify
that the vertical and horizontal locations, and
dimensions shown on this plan are a true and
correct record of the As Constructed information.

Director
Cadastral Surveyor

Date 14/09/2022

I,
hereby certify that the As Constructed
information shown on this plan is a true and
correct record of sizes, types, materials,
classes etc, and it corresponds with the
relevant approved Engineering Drawings

Signed

RPEQ No. Date



Revisions			
Rev	Description	Date	Initial
A	ORIGINAL	3/11/21	NCR
B	Engineers Amendments	3/03/22	NCR
C	Engineers Amendments	12/09/22	NCR



SEWER - AS CONSTRUCTED

309 Priestdale Road
Rosedale
QLD, 4123

Client:	R&F Property Australia Pty Ltd
Job No:	160025
Authority:	Brisbane City Council
Plan No:	160025_033_ASC.pdf
DWG File:	160025_033_ASC.dwg
Level Origin & Datum:	PSM180546 71.303 AHD
1:200 @ A1	Drawn: GW
Date:	12/09/22

BENNETT + BENNETT

PO Box 5021, GCMC QLD 9726
Ph: (07) 5631 8000
mail@bennettandbennett.com.au
www.bennettandbennett.com.au

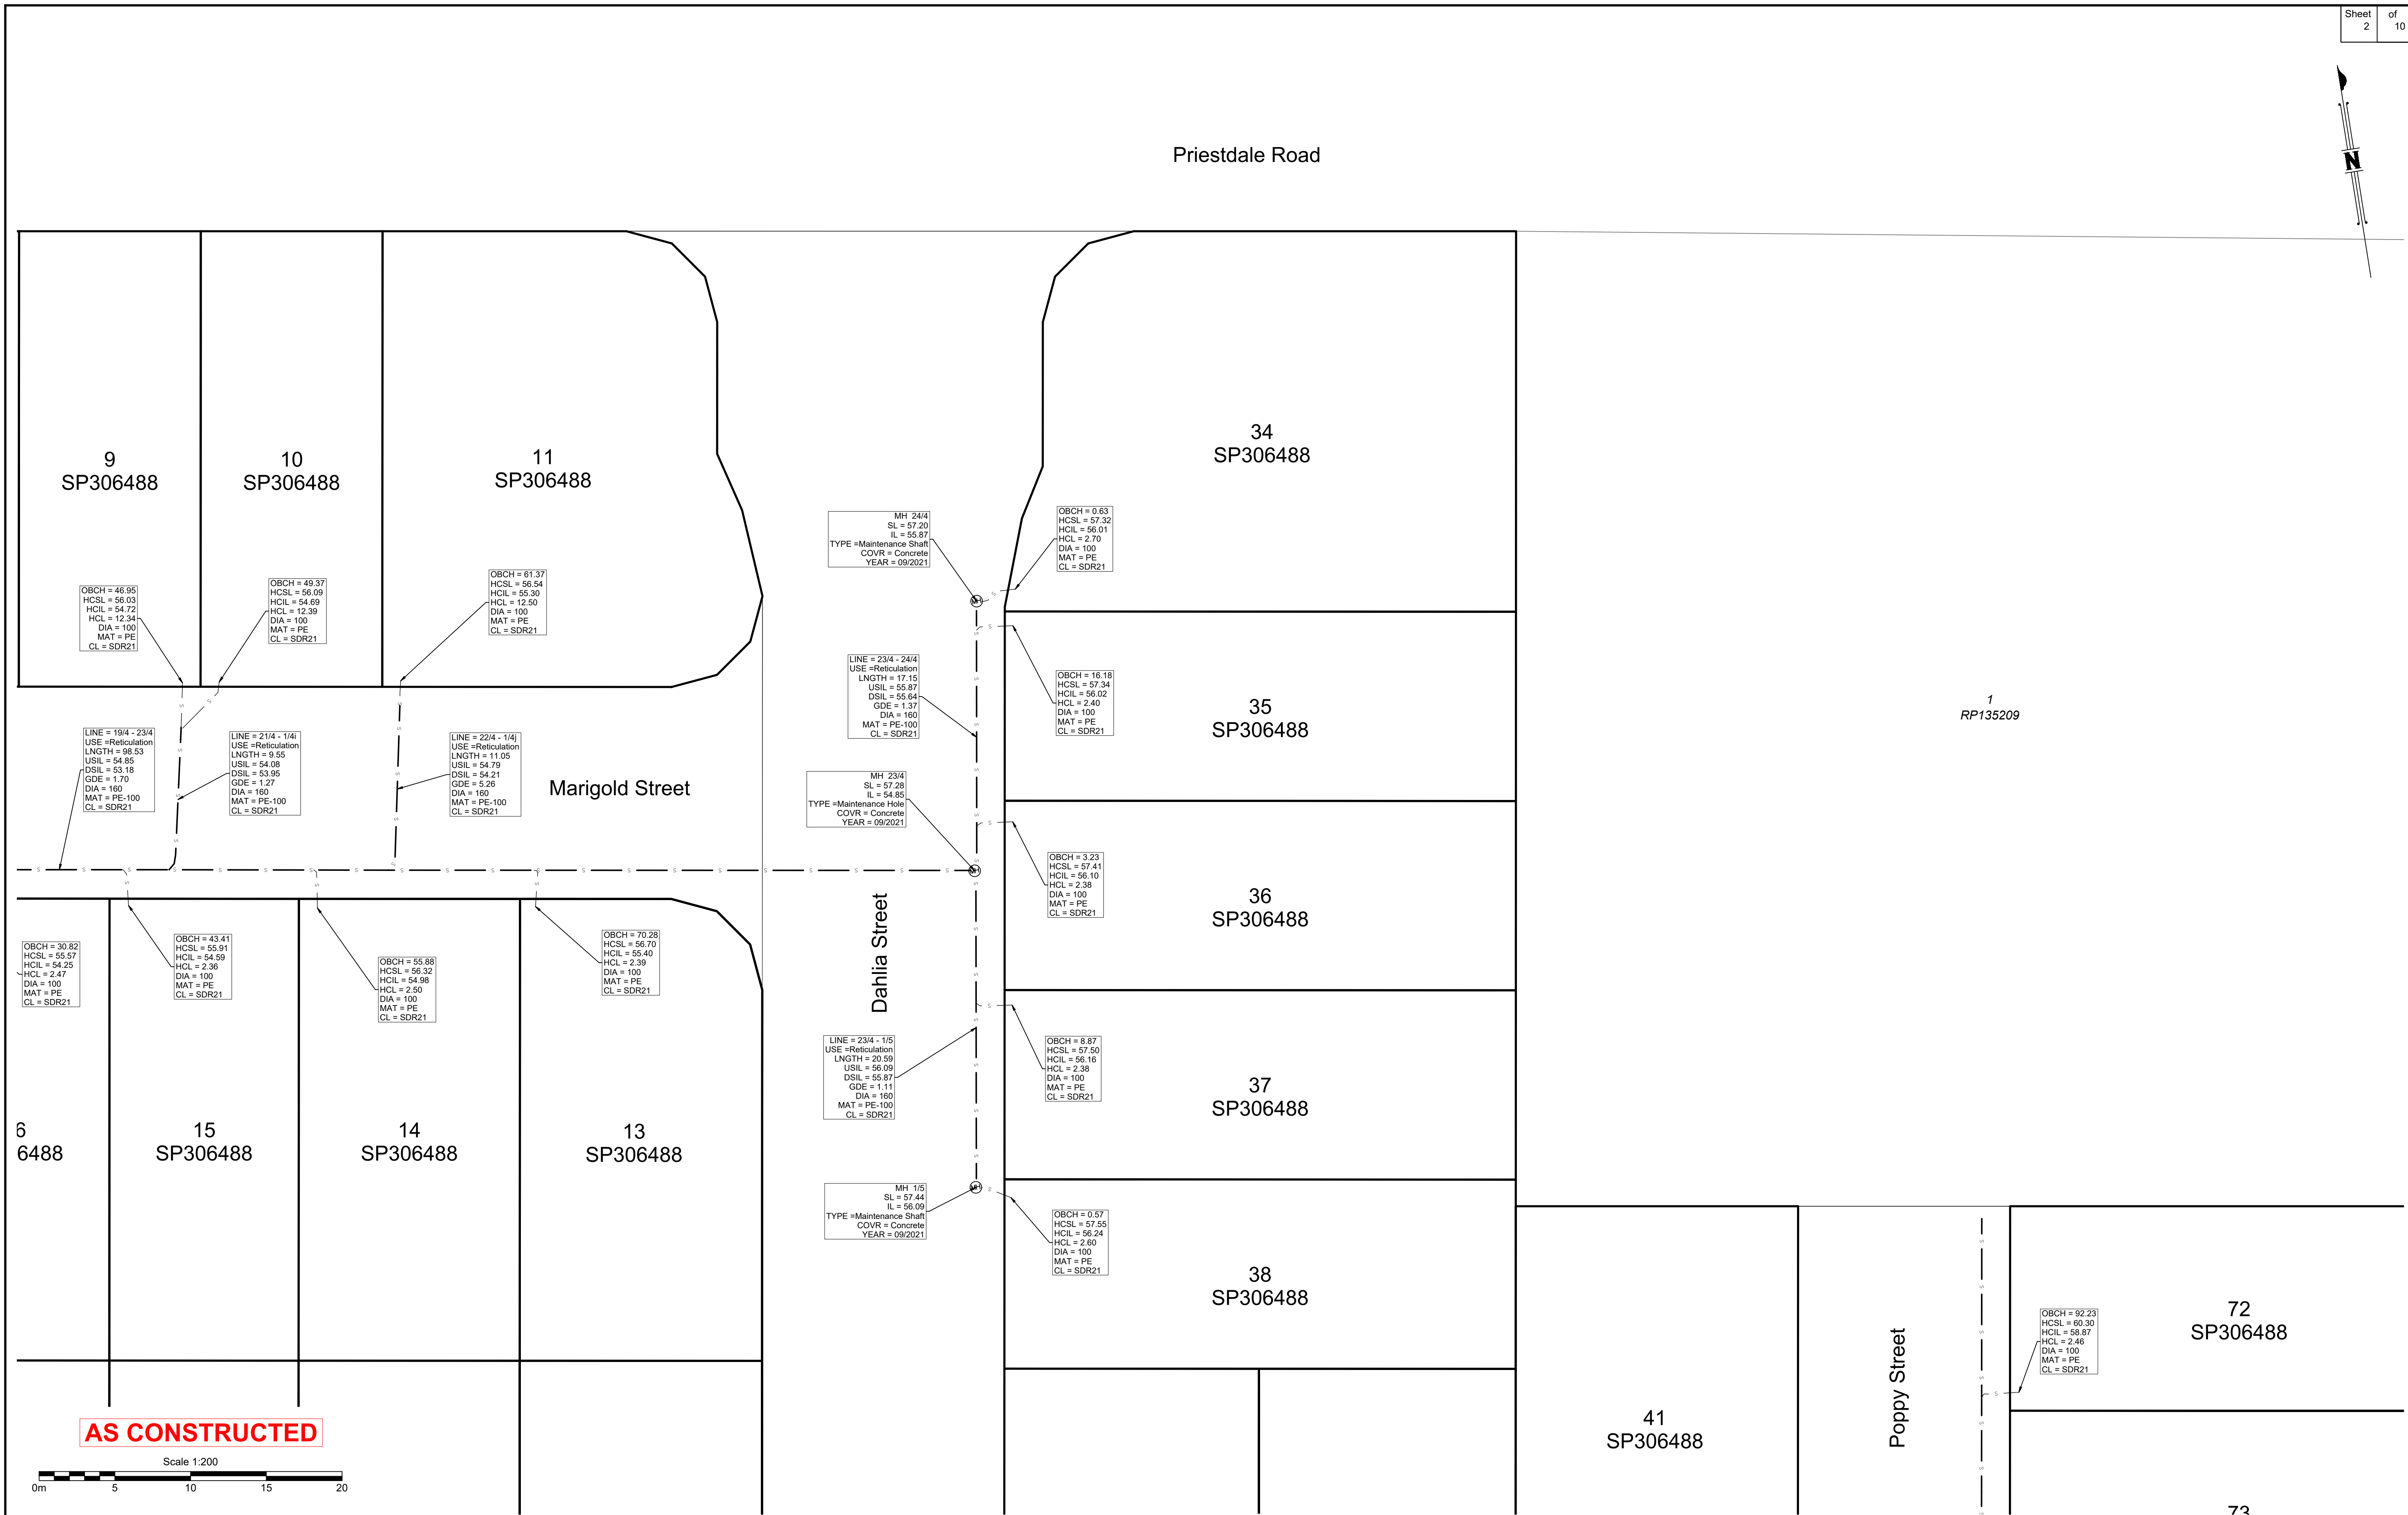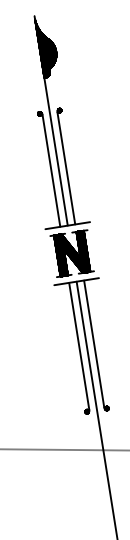

B.B.H PTY. LTD ABN 010 427 531
(trading as Bennett and Bennett Group) hereby certify that the vertical and horizontal locations, and dimensions shown on this plan are a true and correct record of the As Constructed information.

[Signature]
Director
Cadastral Surveyor

Date 14/09/2022

I, hereby certify that the As Constructed information shown on this plan is a true and correct record of sizes, types, materials, classes etc, and it corresponds with the relevant approved Engineering Drawings

Signed
RPEQ No. Date


Revisions			
Rev	Description	Date	Initial
A	ORIGINAL	3/11/21	NCR
B	Engineers Amendments	3/03/22	NCR
C	Engineers Amendments	12/09/22	NCR

SEWER - AS CONSTRUCTED

309 Priestdale Road
Rosedale
QLD, 4123

Client: R&F Property Australia Pty Ltd
Job No: 160025
Authority: Brisbane City Council
Plan No: 160025_033_ASC.pdf
DWG File: 160025_033_ASC.dwg
Level Origin & Datum: 71.303 AHD
1:200 @ A1 Drawn: GW
Date: 12/09/22

PO Box 5021, GCMC QLD 9726
Ph: (07) 5631 8000
mail@bennettandbennett.com.au
www.bennettandbennett.com.au

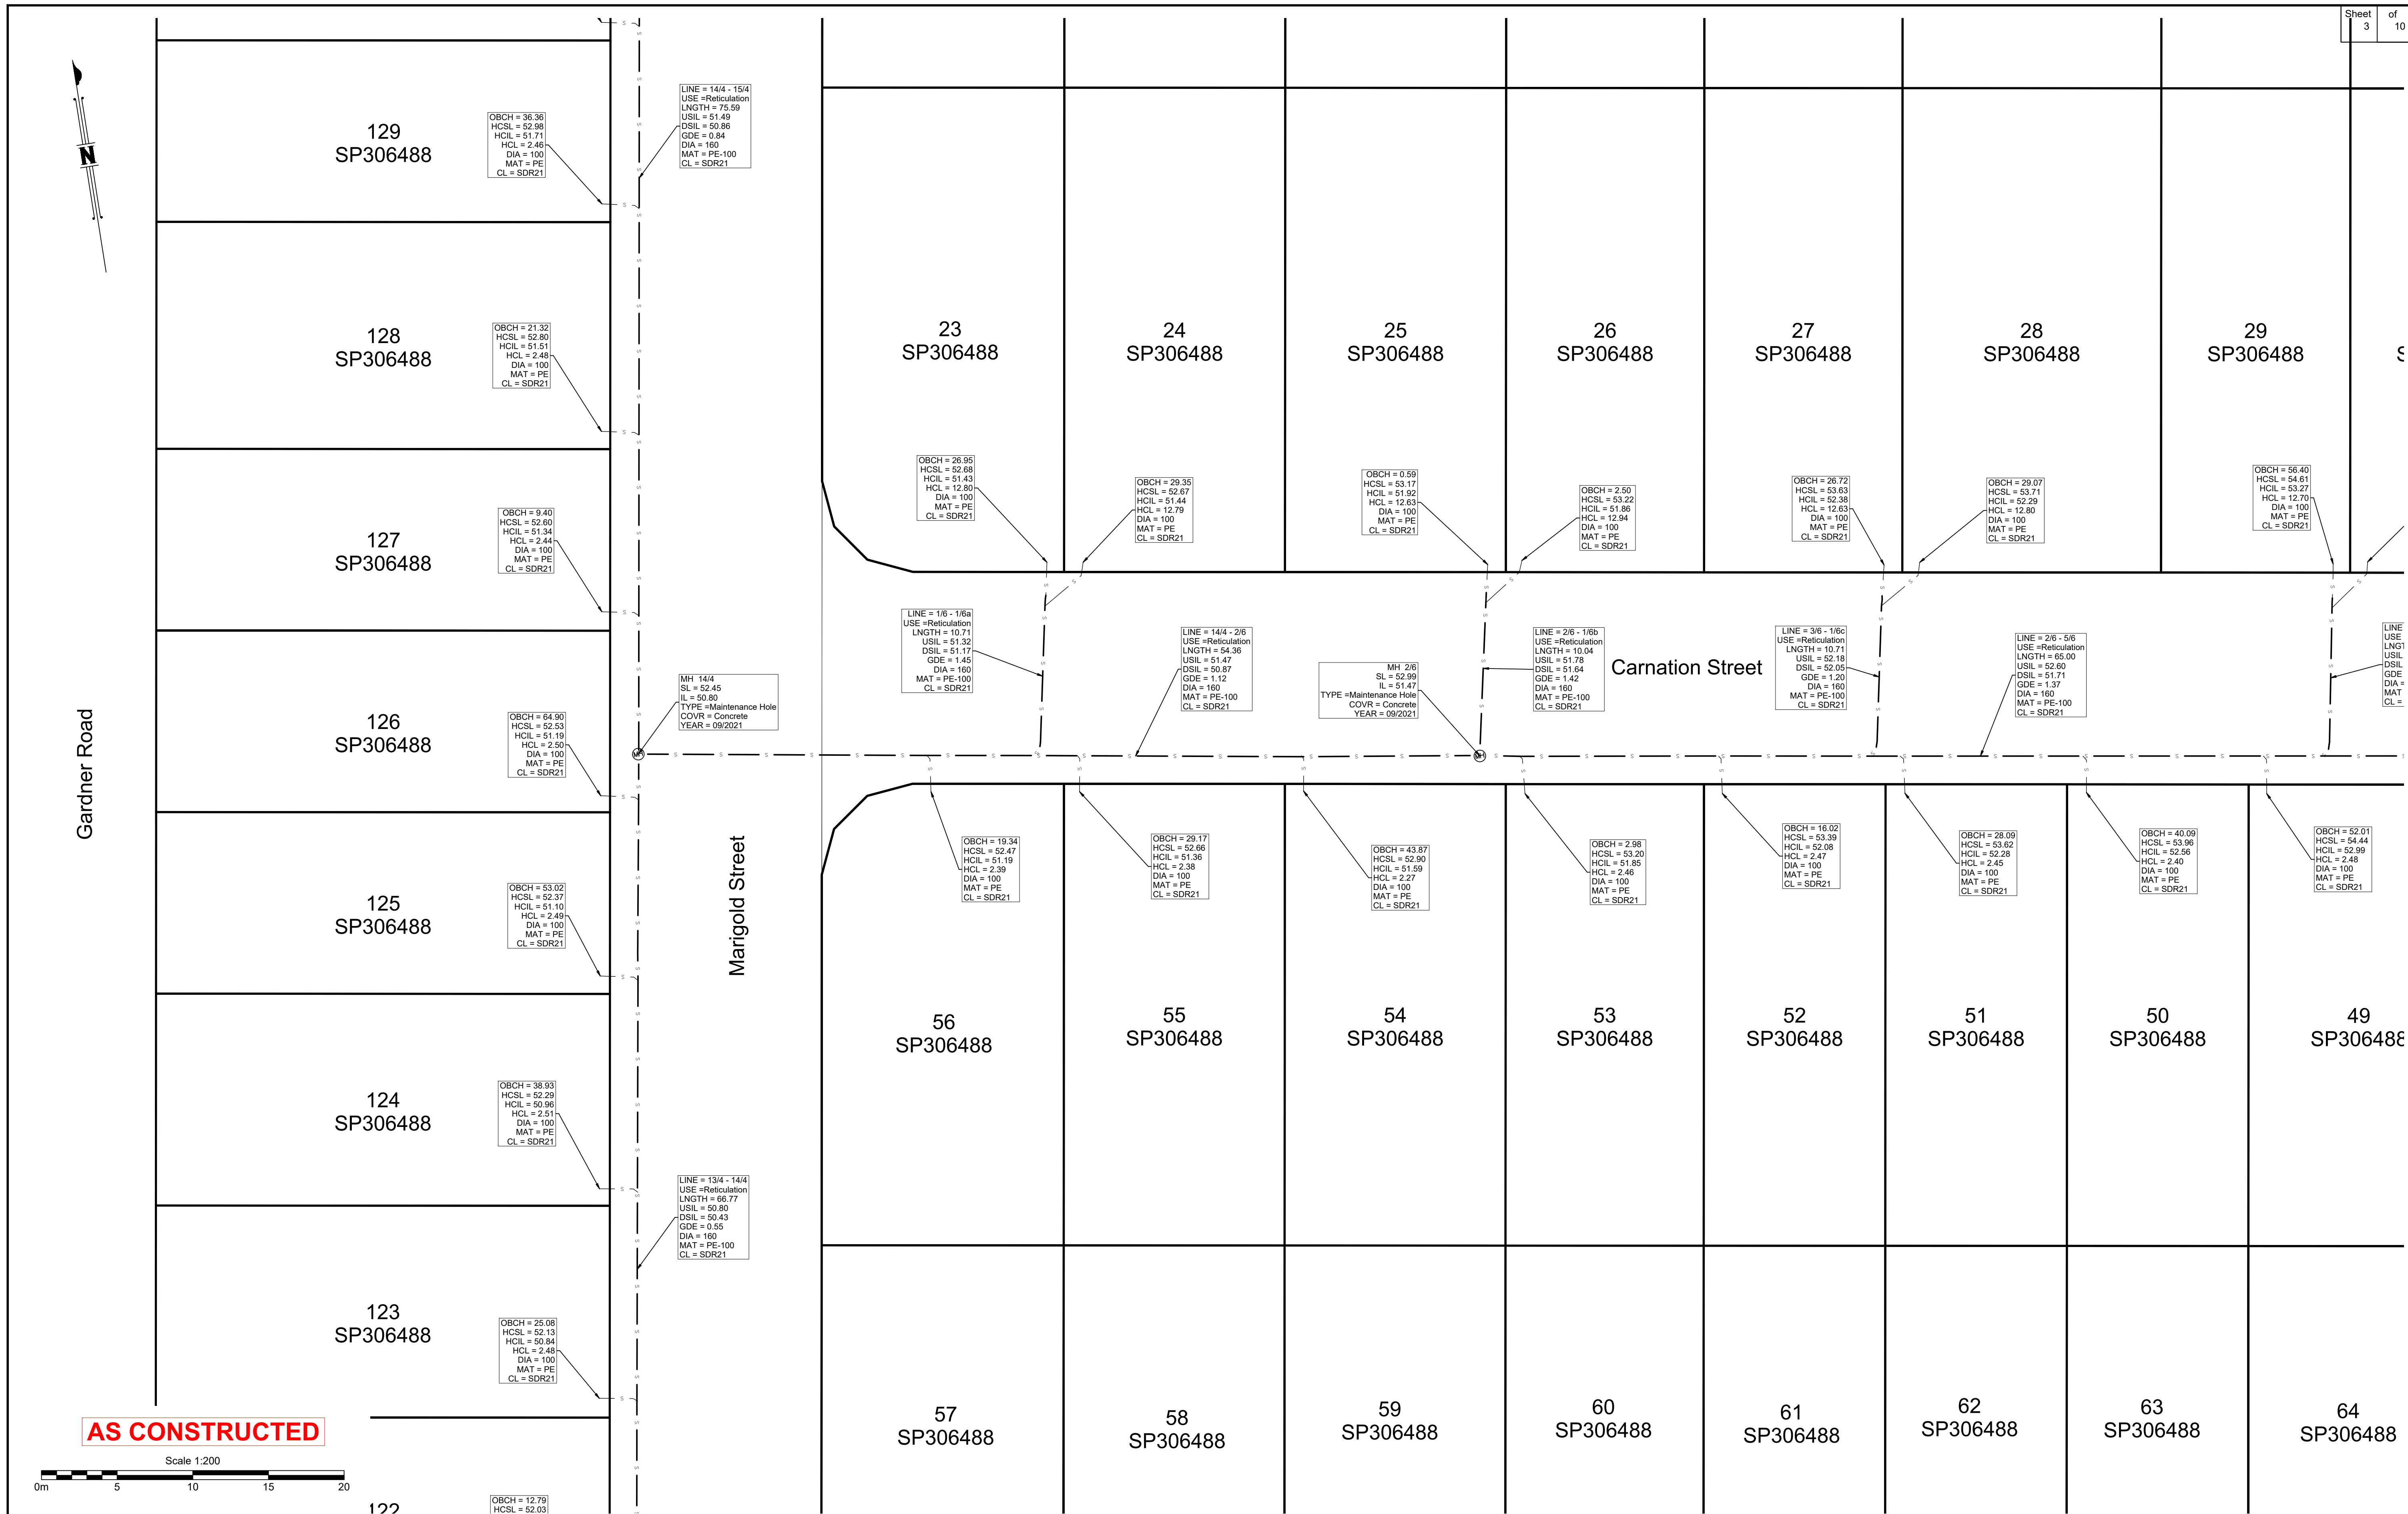

B.B.H PTY. LTD ABN 010 427 531
(trading as Bennett and Bennett Group) hereby certify
that the vertical and horizontal locations, and
dimensions shown on this plan are a true and
correct record of the As Constructed information.

Director
Cadastral Surveyor

Date 14/09/2022

I,
hereby certify that the As Constructed
information shown on this plan is a true and
correct record of sizes, types, materials,
classes etc, and it corresponds with the
relevant approved Engineering Drawings

Signed

RPEQ No. Date



Revisions			
Rev	Description	Date	Initial
A	ORIGINAL	3/11/21	NCR
B	Engineers Amendments	3/03/22	NCR
C	Engineers Amendments	12/09/22	NCR


SEWER - AS CONSTRUCTED

309 Priestdale Road
Rosedale
QLD, 4123

Client:	R&F Property Australia Pty Ltd
Job No:	160025
Authority:	Brisbane City Council
Plan No:	160025_033_ASC.pdf
DWG File:	160025_033_ASC.dwg
Level Origin & Datum:	PSM180546 71.303 AHD
1:200 @ A1	Drawn: GW
Date:	12/09/22

BENNETT + BENNETT

PO Box 5021, GCMC QLD 9726
Ph: (07) 5631 8000
mail@bennettandbennett.com.au
www.bennettandbennett.com.au

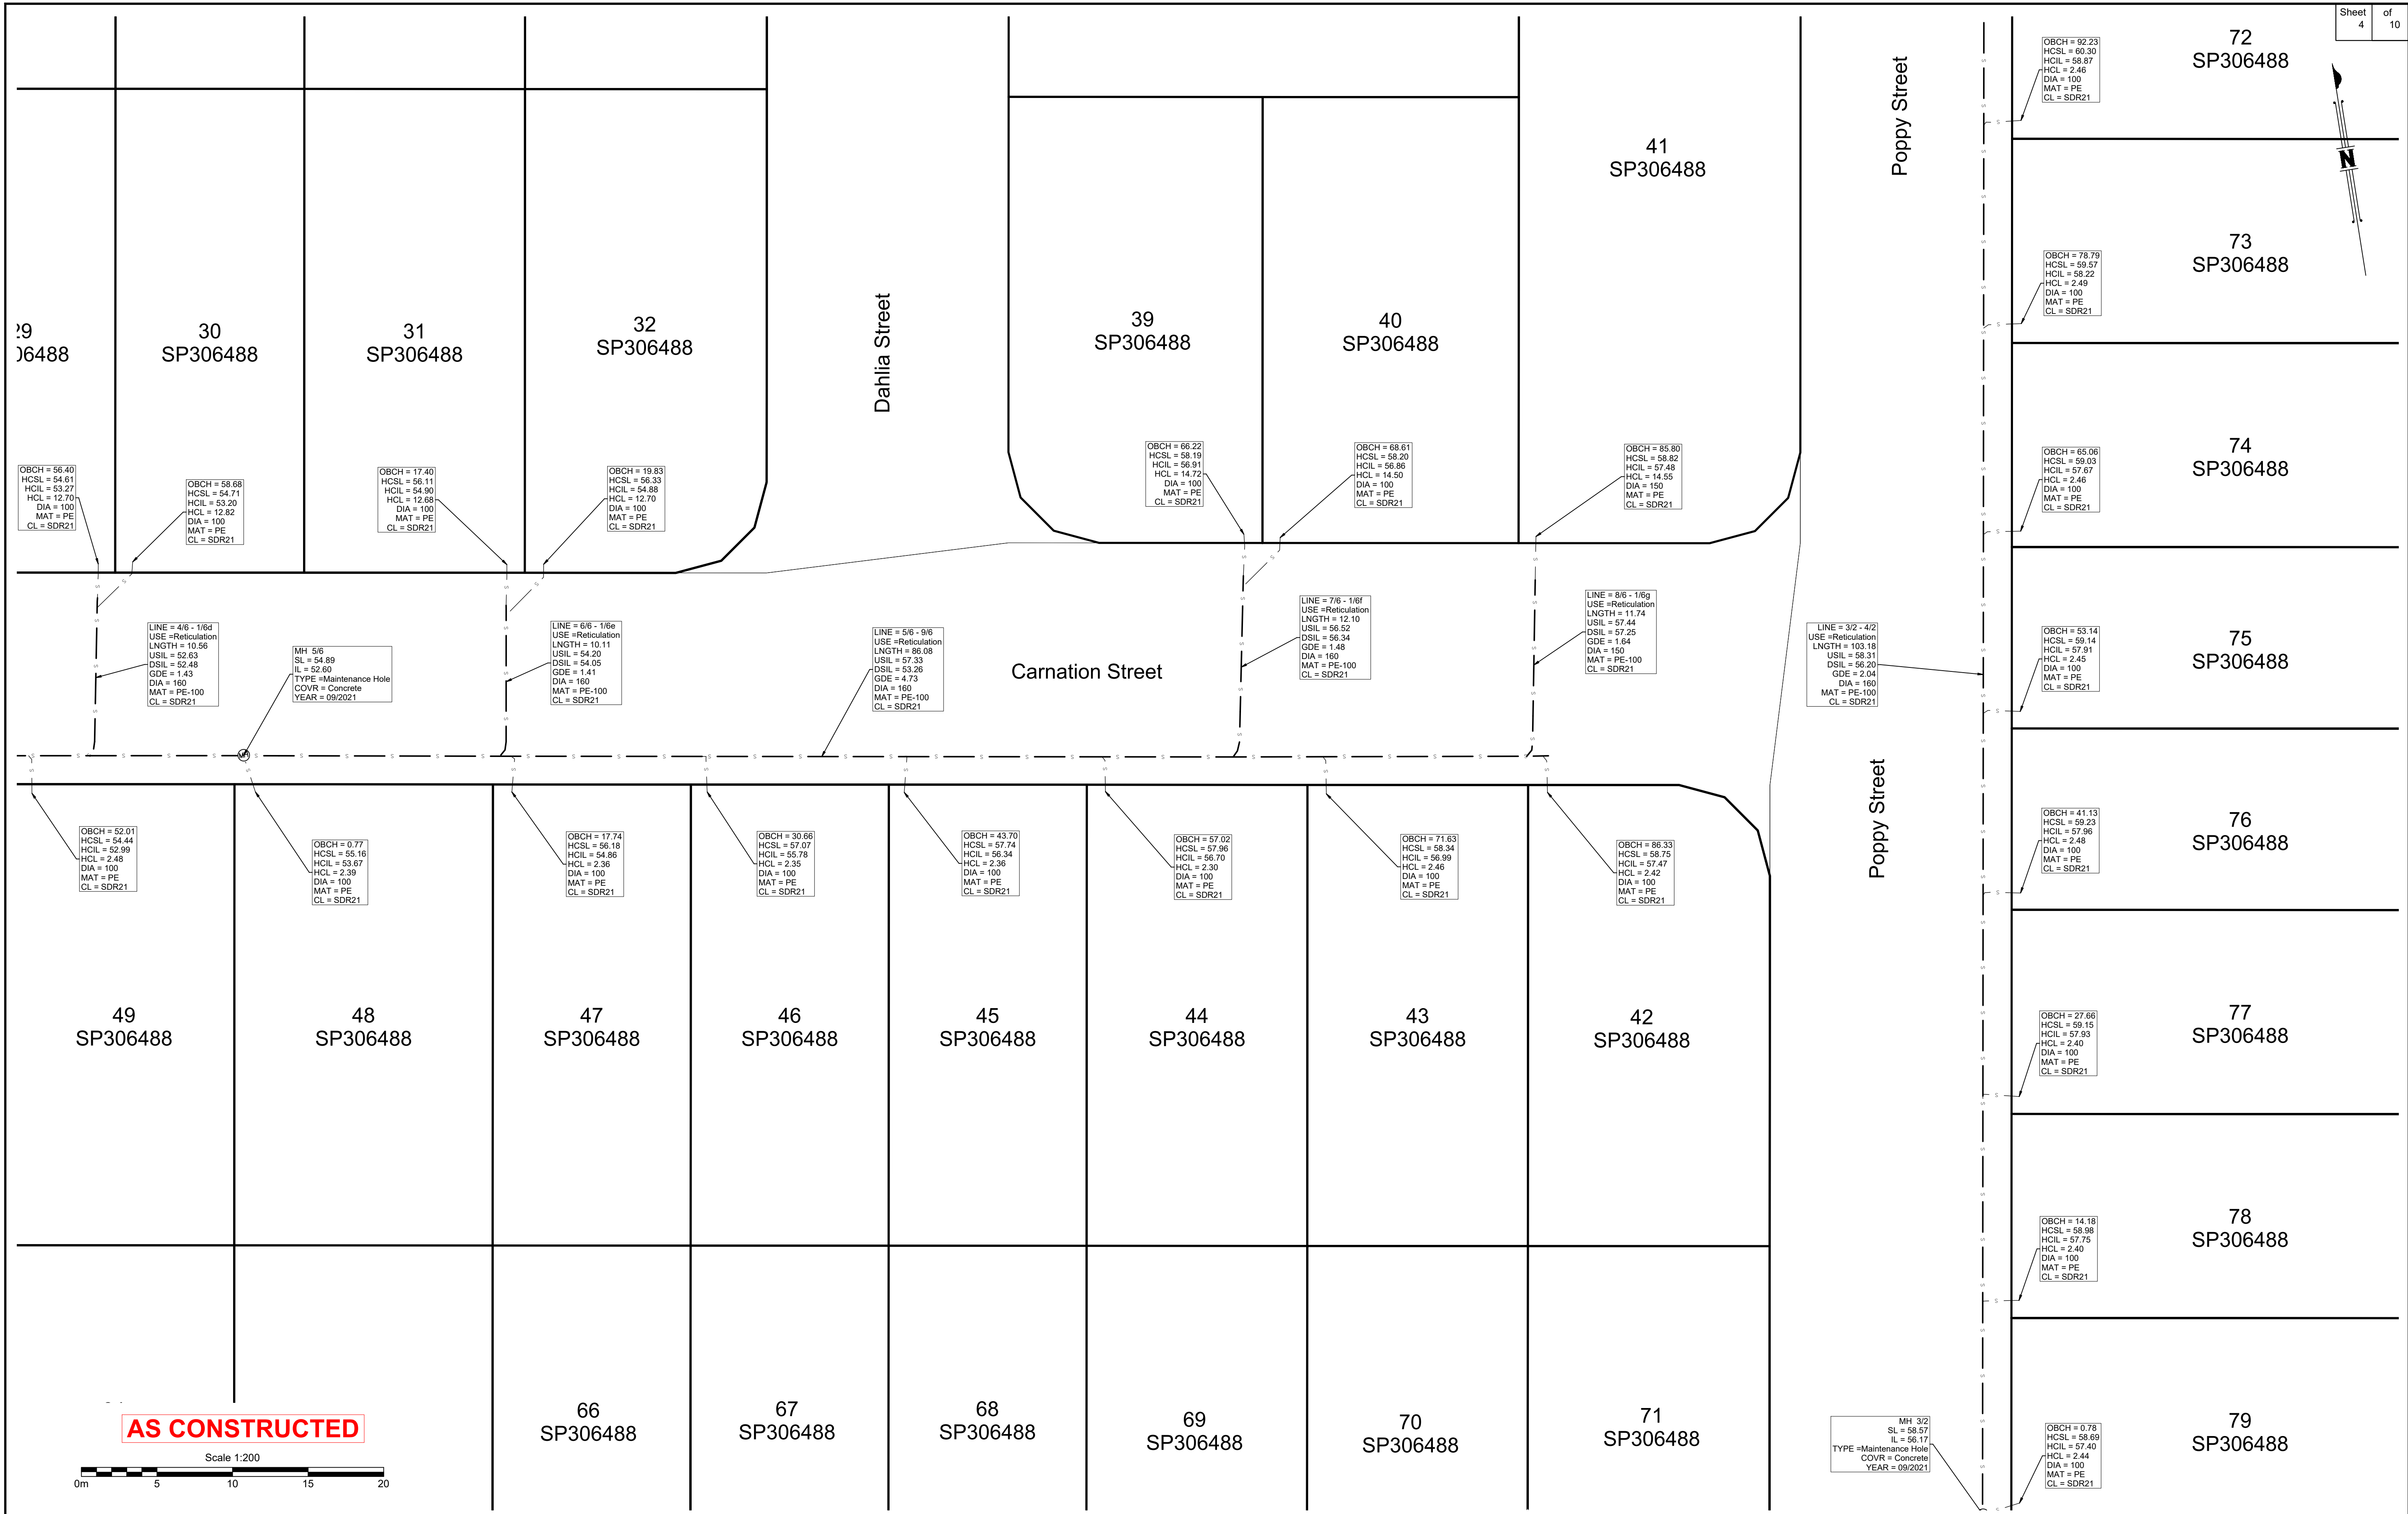

B.B.H PTY. LTD ABN 010 427 531
(trading as Bennett and Bennett Group) hereby certify that the vertical and horizontal locations, and dimensions shown on this plan are a true and correct record of the As Constructed information.

Director
Cadastral Surveyor

Date 14/09/2022

I, _____ hereby certify that the As Constructed information shown on this plan is a true and correct record of sizes, types, materials, classes etc, and it corresponds with the relevant approved Engineering Drawings

Signed _____

RPEQ No. _____ Date _____

QUEENSLAND
UrbanUtilities

Revisions			
Rev	Description	Date	Initial
A	ORIGINAL	3/11/21	NCR
B	Engineers Amendments	3/03/22	NCR
C	Engineers Amendments	12/09/22	NCR

SEWER - AS CONSTRUCTED

309 Priestdale Road
Rosedale
QLD, 4123

Client: R&F Property Australia Pty Ltd

Job No: 160025

Authority: Brisbane City Council

Plan No: 160025_033_ASC.pdf

DWG File: 160025_033_ASC.dwg


Level Origin & Datum: 71.303 AHD

1:200 @ A1 Drawn: GW

Date: 12/09/22

BENNETT + BENNETT

PO Box 5021, GCMC QLD 9726
Ph: (07) 5631 8000
mail@bennettandbennett.com.au
www.bennettandbennett.com.au

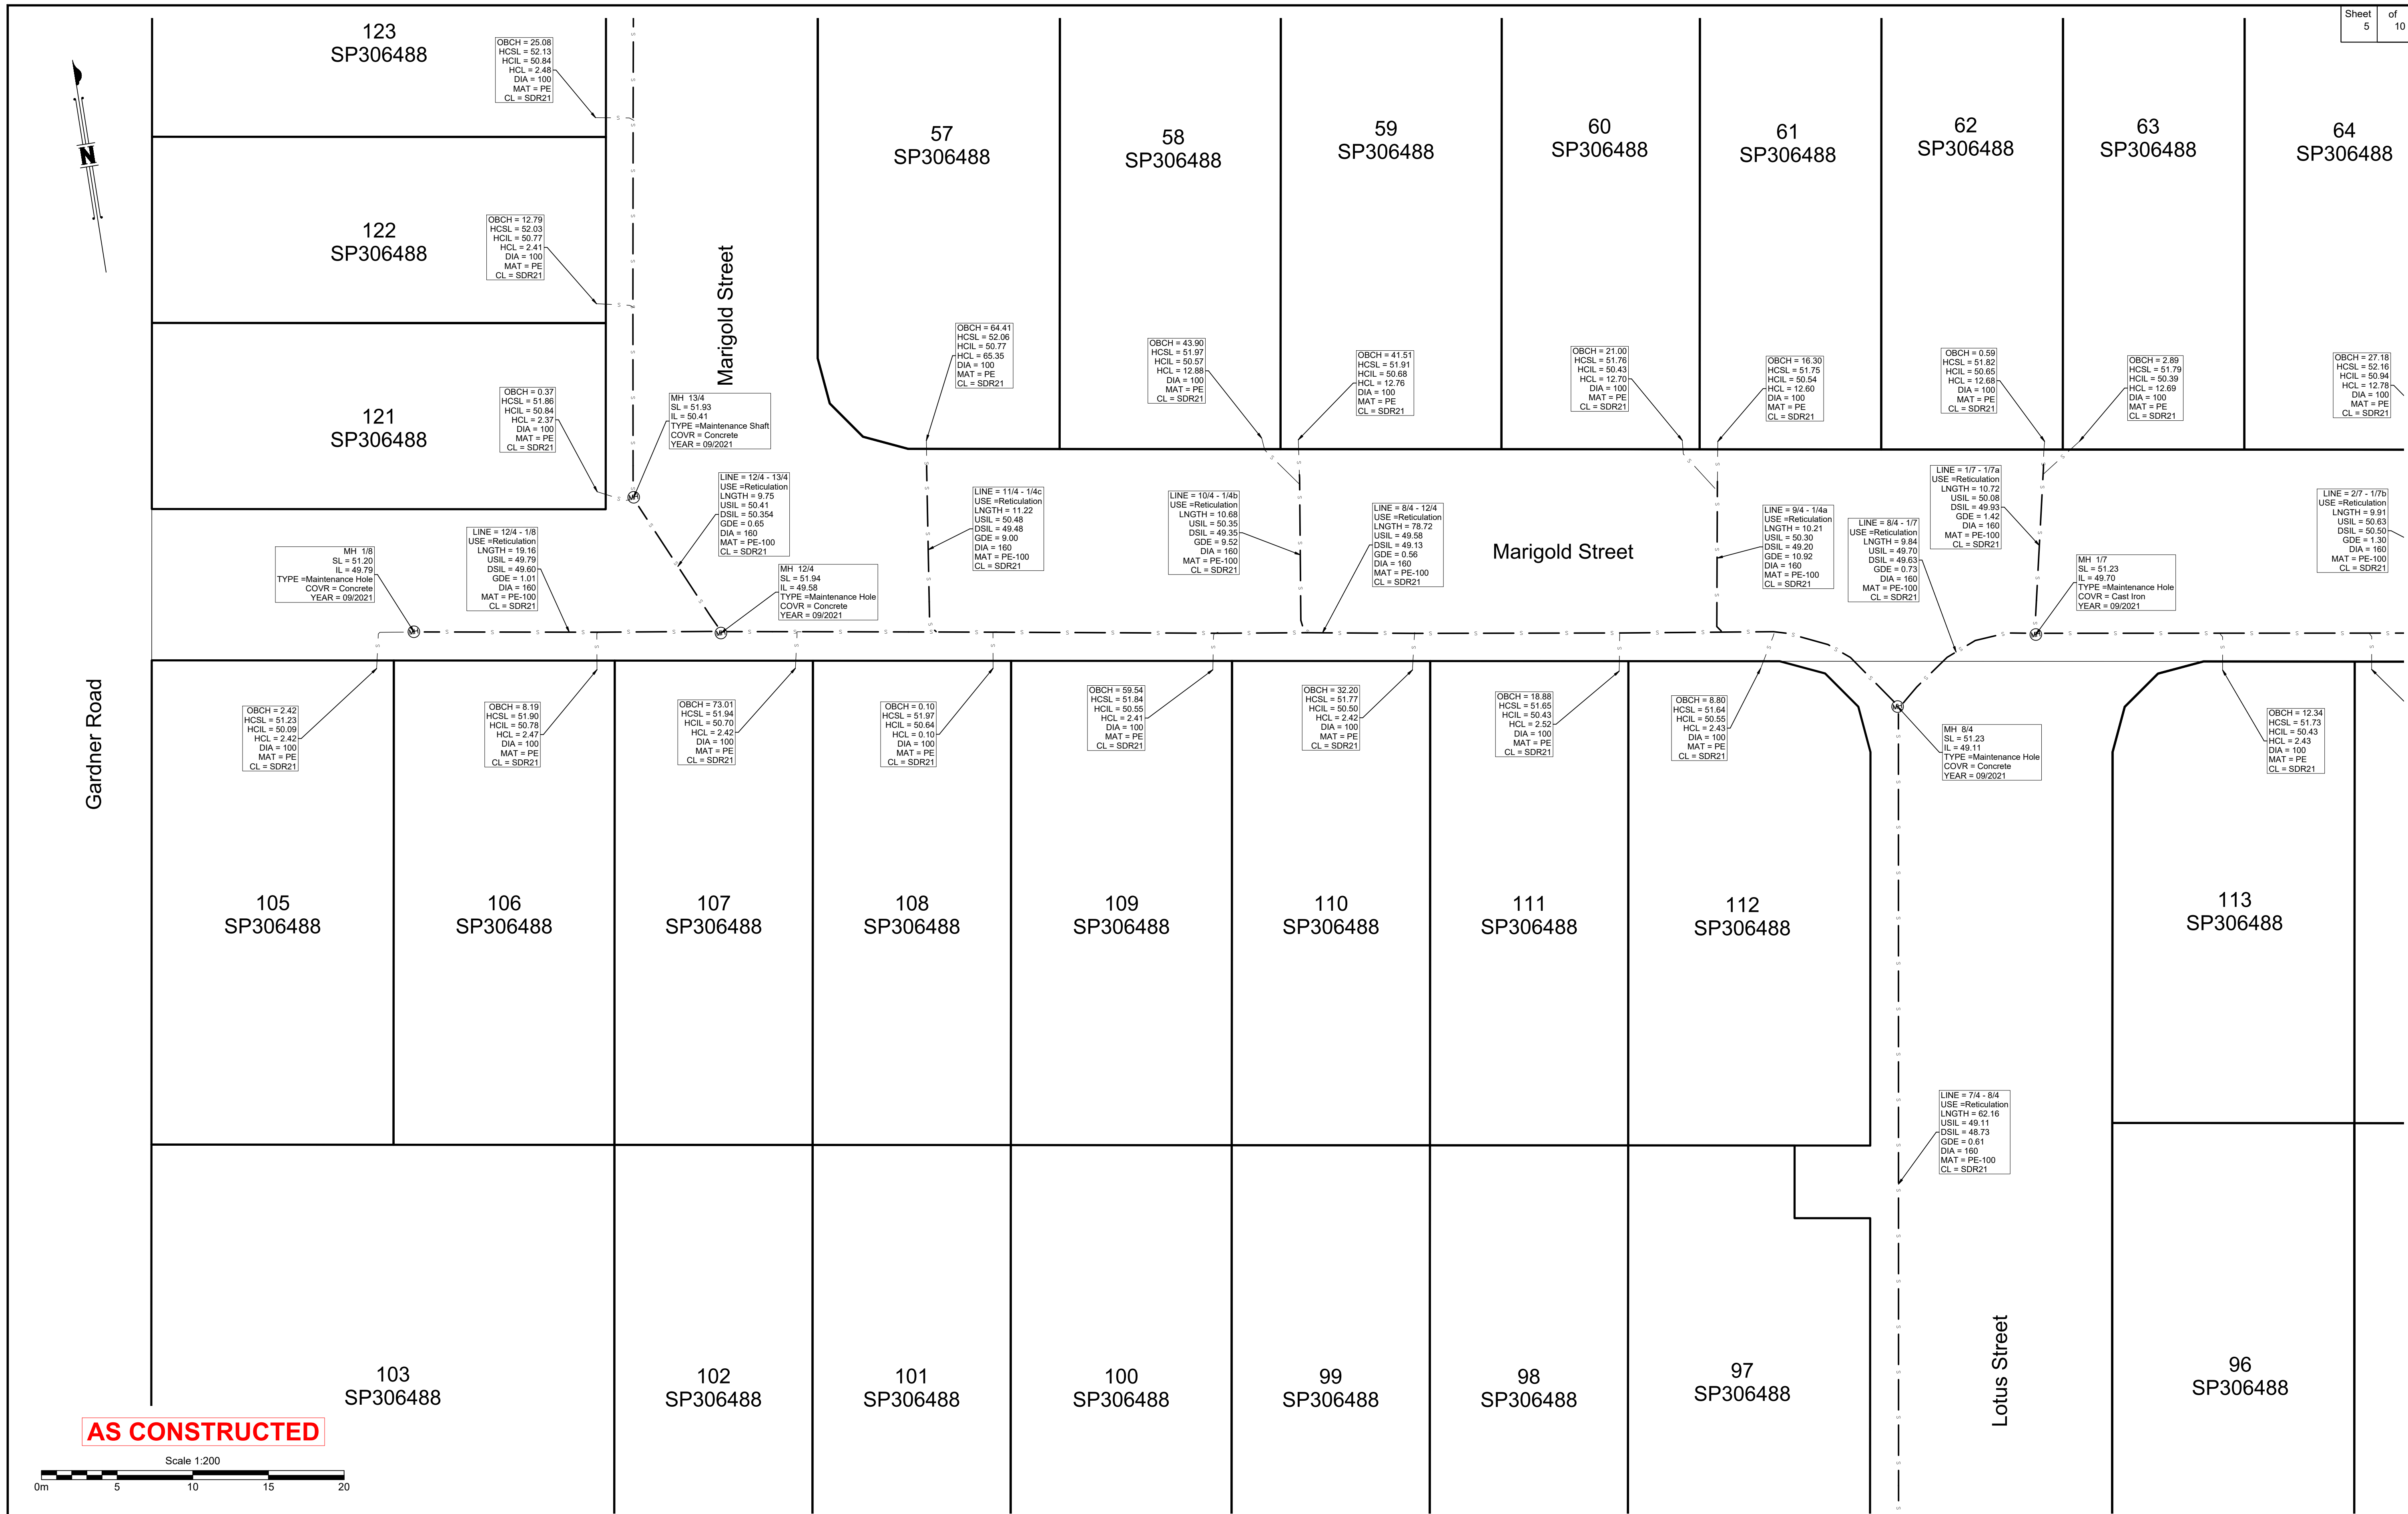

B.B.H PTY. LTD ABN 010 427 531
(trading as Bennett and Bennett Group) hereby certify
that the vertical and horizontal locations, and
dimensions shown on this plan are a true and
correct record of the As Constructed information.

Director
Cadastral Surveyor

Date 14/09/2022

I,
hereby certify that the As Constructed
information shown on this plan is a true and
correct record of sizes, types, materials,
classes etc, and it corresponds with the
relevant approved Engineering Drawings

Signed

RPEQ No. Date



Revisions			
Rev	Description	Date	Initial
A	ORIGINAL	3/11/21	NCR
B	Engineers Amendments	3/03/22	NCR
C	Engineers Amendments	12/09/22	NCR


SEWER - AS CONSTRUCTED

309 Priestdale Road
Rosedale
QLD, 4123

Client:	R&F Property Australia Pty Ltd
Job No:	160025
Authority:	Brisbane City Council
Plan No:	160025_033_ASC.pdf
DWG File:	160025_033_ASC.dwg
Level Origin & Datum:	PSM180546 71.303 AHD
1:200 @ A1	Drawn: GW
Date:	12/09/22

BENNETT + BENNETT

PO Box 5021, GCMC QLD 9726
Ph: (07) 5631 8000
mail@bennettandbennett.com.au
www.bennettandbennett.com.au

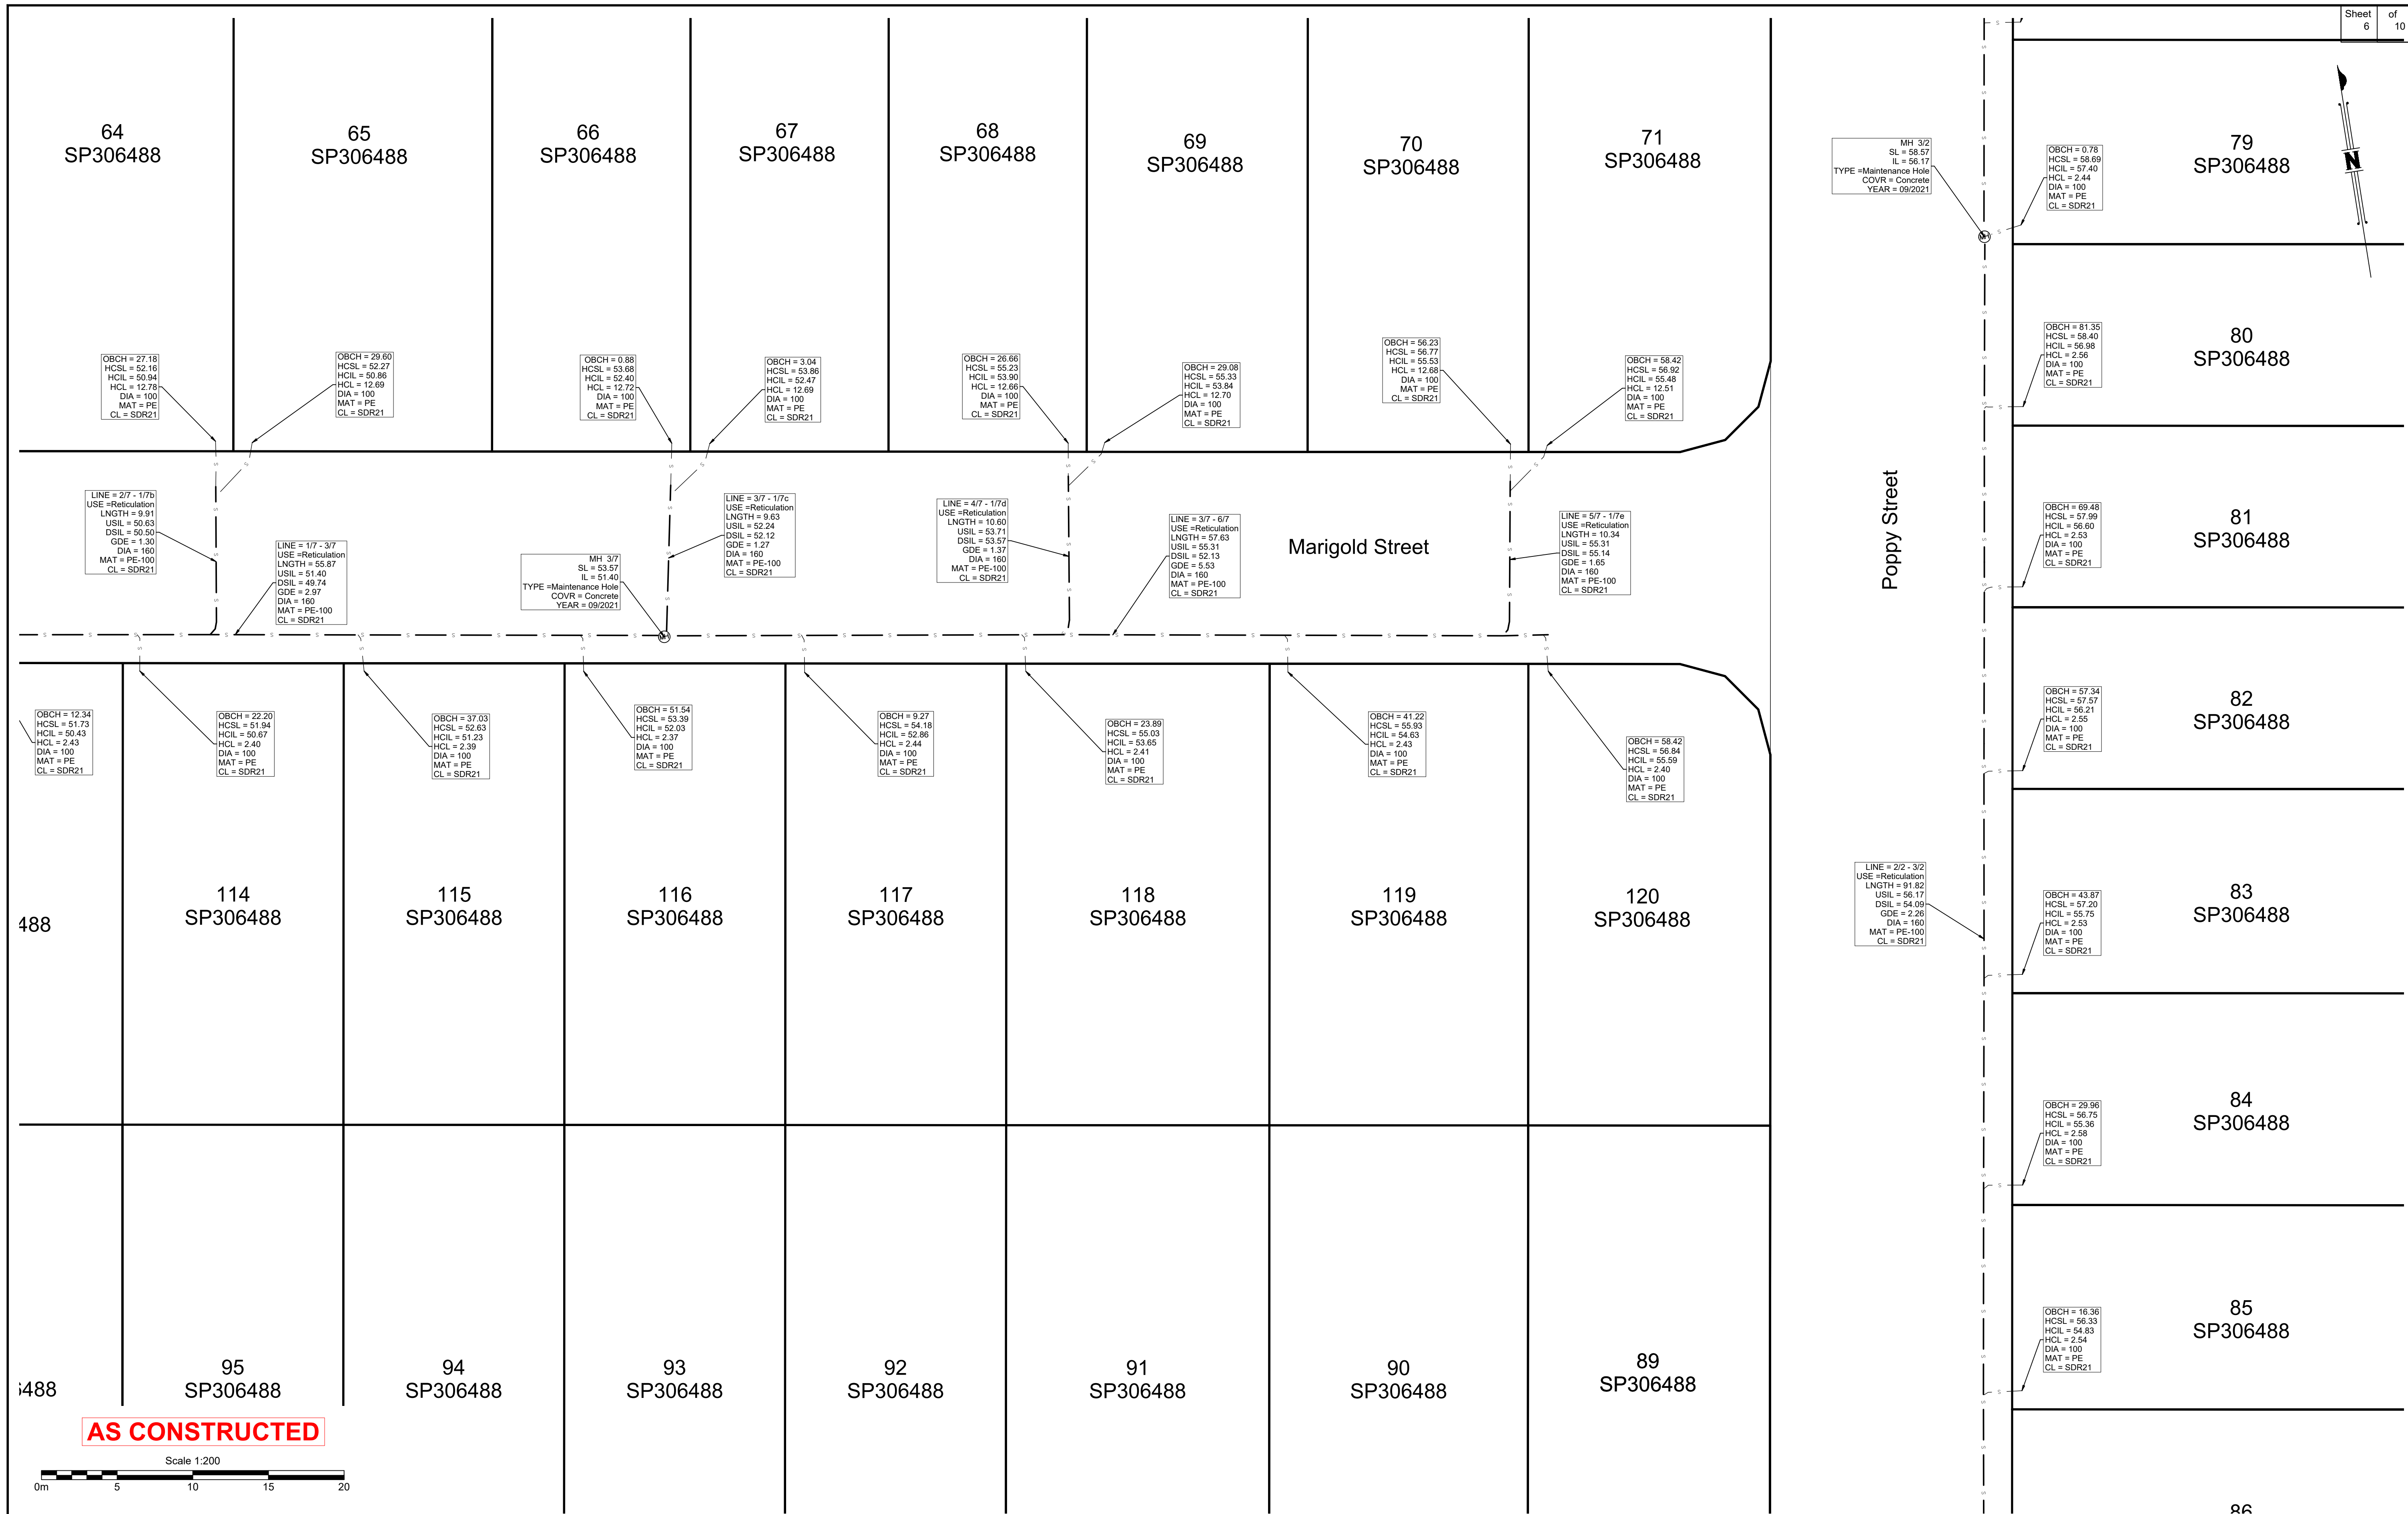

B.B.H PTY. LTD ABN 010 427 531
(trading as Bennett and Bennett Group) hereby certify
that the vertical and horizontal locations, and
dimensions shown on this plan are a true and
correct record of the As Constructed information.

Director
Cadastral Surveyor

Date 14/09/2022

I,
hereby certify that the As Constructed
information shown on this plan is a true and
correct record of sizes, types, materials,
classes etc, and it corresponds with the
relevant approved Engineering Drawings

Signed
RPEQ No. Date

QUEENSLAND
UrbanUtilities

Revisions			
Rev	Description	Date	Initial
A	ORIGINAL	3/11/21	NCR
B	Engineers Amendments	3/03/22	NCR
C	Engineers Amendments	12/09/22	NCR

SEWER - AS CONSTRUCTED

309 Priestdale Road
Rosedale
QLD, 4123

Client: R&F Property Australia Pty Ltd

Job No: 160025

Authority: Brisbane City Council

Plan No: 160025_033_ASC.pdf

DWG File: 160025_033_ASC.dwg


Level Origin & Datum: 71.303 AHD

1:200 @ A1 Drawn: GW


Date: 12/09/22

BENNETT + BENNETT

PO Box 5021, GCMC QLD 9726
Ph: (07) 5631 8000
mail@bennettandbennett.com.au
www.bennettandbennett.com.au

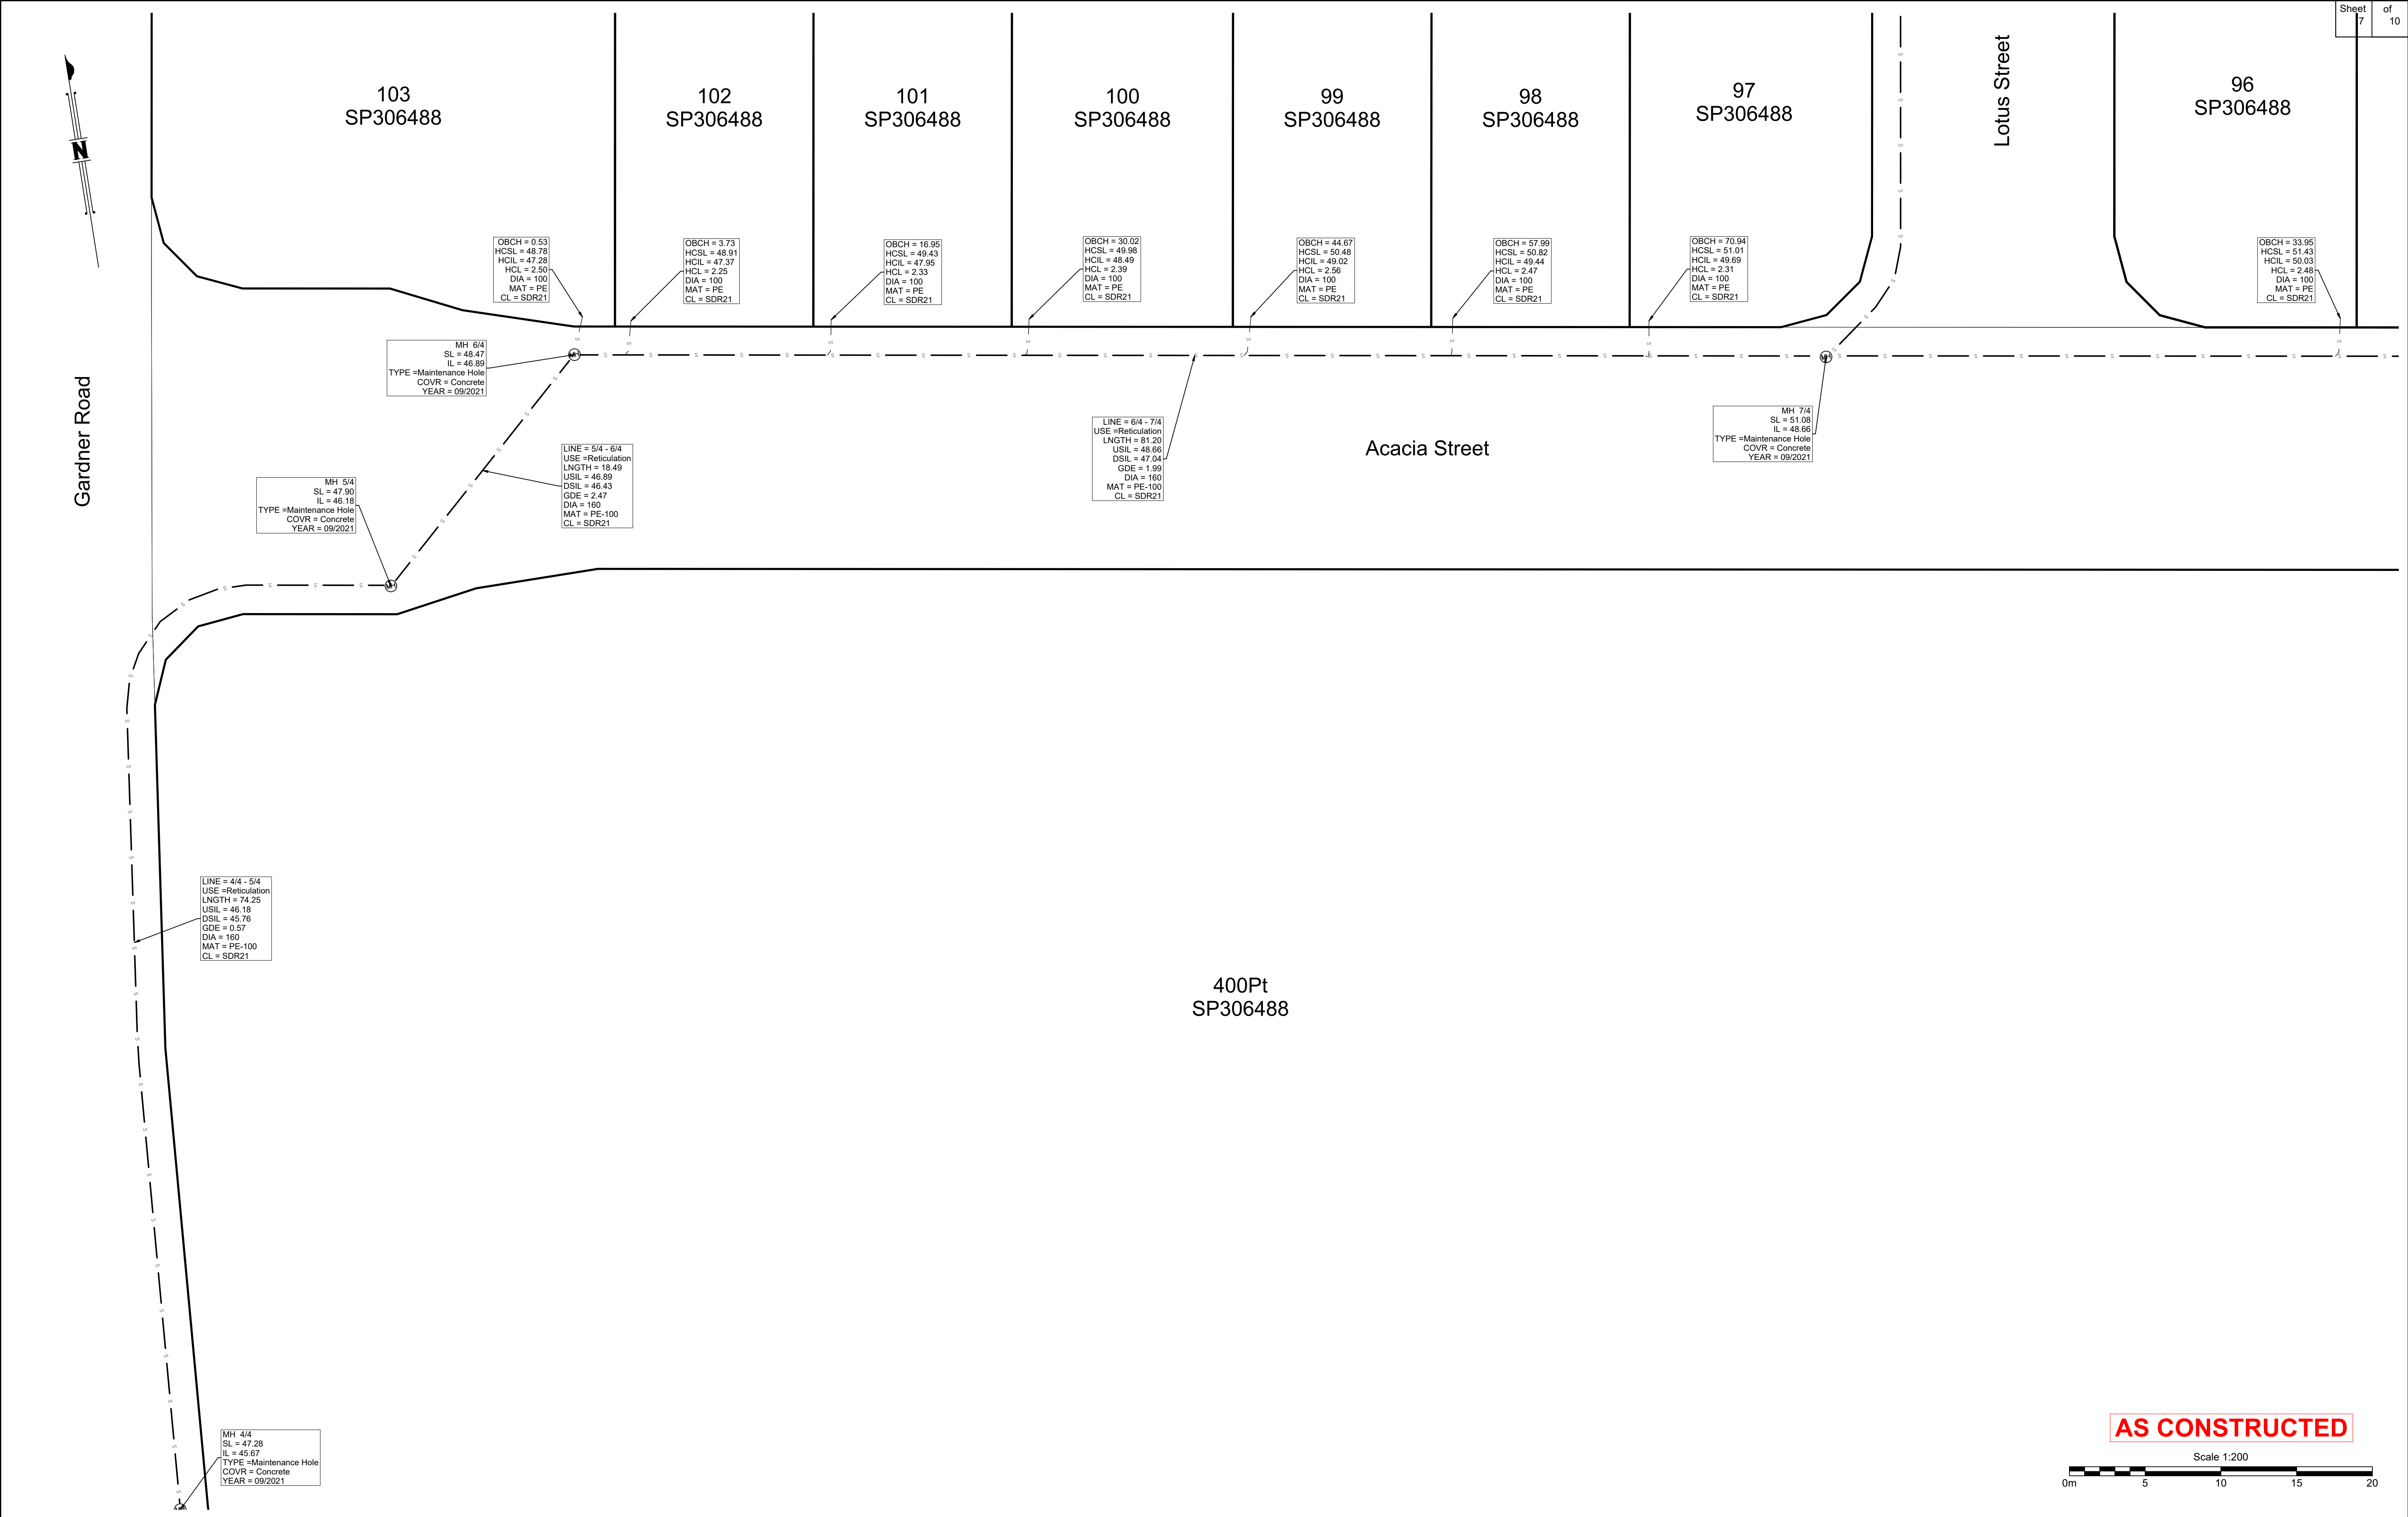

AS CONSTRUCTED

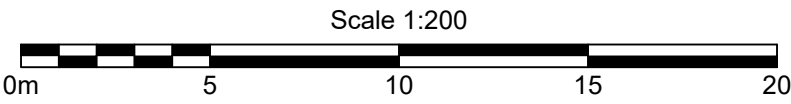

B.B.H PTY. LTD ABN 010 427 531
(trading as Bennett and Bennett Group) hereby certify
that the vertical and horizontal locations, and
dimensions shown on this plan are a true and
correct record of the As Constructed information.

Director
Cadastral Surveyor
Date 14/09/2022

I,
hereby certify that the As Constructed
information shown on this plan is a true and
correct record of sizes, types, materials,
classes etc, and it corresponds with the
relevant approved Engineering Drawings

Signed
RPEQ No. Date




Revisions			
Rev	Description	Date	Initial
A	ORIGINAL	3/11/21	NCR
B	Engineers Amendments	3/03/22	NCR
C	Engineers Amendments	12/09/22	NCR

SEWER - AS CONSTRUCTED
309 Priestdale Road
Rosedale
QLD, 4123

Client:	R&F Property Australia Pty Ltd		
Job No:	160025		
Authority:	Brisbane City Council		
Plan No:	160025_033_ASC.pdf		
DWG File:	160025_033_ASC.dwg		
Level Origin & Datum:	PSM180546 71.303 AHD		
1:200 @ A1	Drawn:	GW	
Date:	12/09/22		

BENNETT + BENNETT
PO Box 5021, GCMC QLD 9726
Ph: (07) 5631 8000
mail@bennettandbennett.com.au
www.bennettandbennett.com.au

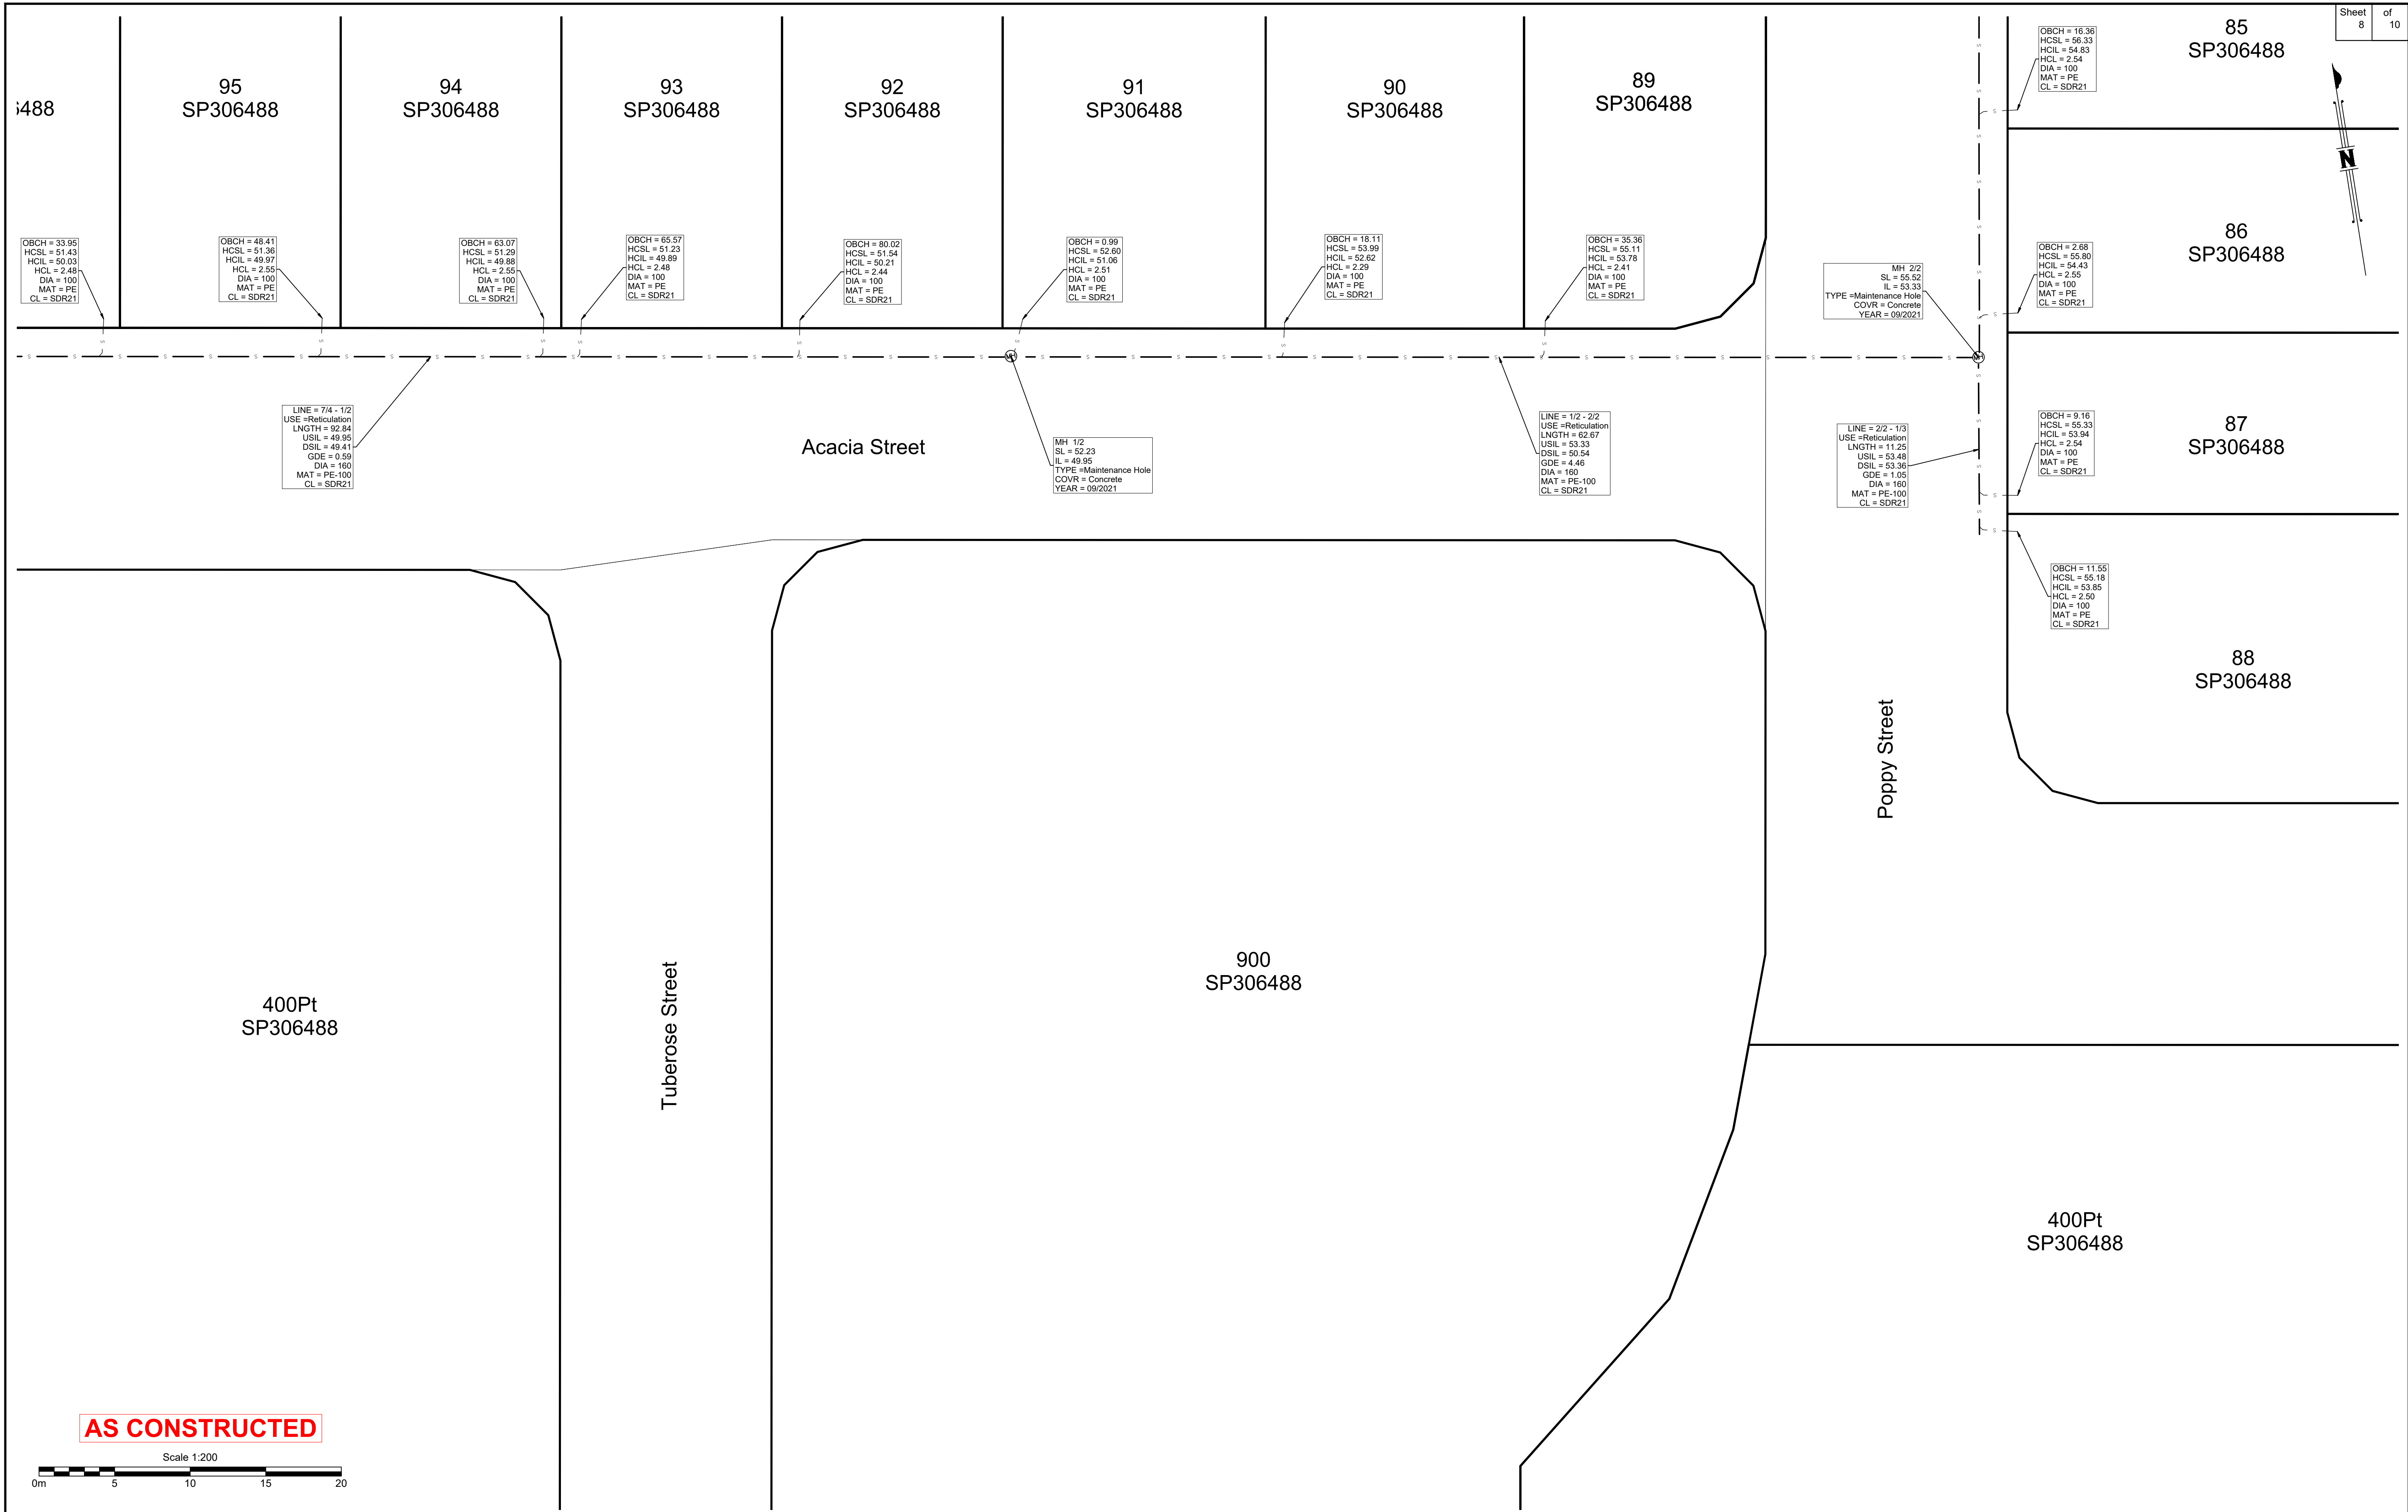

B.B.H PTY. LTD ABN 010 427 531
(trading as Bennett and Bennett Group) hereby certify
that the vertical and horizontal locations, and
dimensions shown on this plan are a true and
correct record of the As Constructed information.

Director
Cadastral Surveyor

Date 14/09/2022

I,
hereby certify that the As Constructed
information shown on this plan is a true and
correct record of sizes, types, materials,
classes etc, and it corresponds with the
relevant approved Engineering Drawings

Signed

RPEQ No. Date

Revisions			
Rev	Description	Date	Initial
A	ORIGINAL	3/11/21	NCR
B	Engineers Amendments	3/03/22	NCR
C	Engineers Amendments	12/09/22	NCR

SEWER - AS CONSTRUCTED

309 Priestdale Road
Rosedale
QLD, 4123

Client: R&F Property Australia Pty Ltd

Job No: 160025

Authority: Brisbane City Council

Plan No: 160025_033_ASC.pdf



DWG File: 160025_033_ASC.dwg

Level Origin & Datum: 71.303 AHD


1:200 @ A1 Drawn: GW

Date: 12/09/22

PO Box 5021, GCMC QLD 9726
Ph: (07) 5631 8000
mail@bennettandbennett.com.au
www.bennettandbennett.com.au

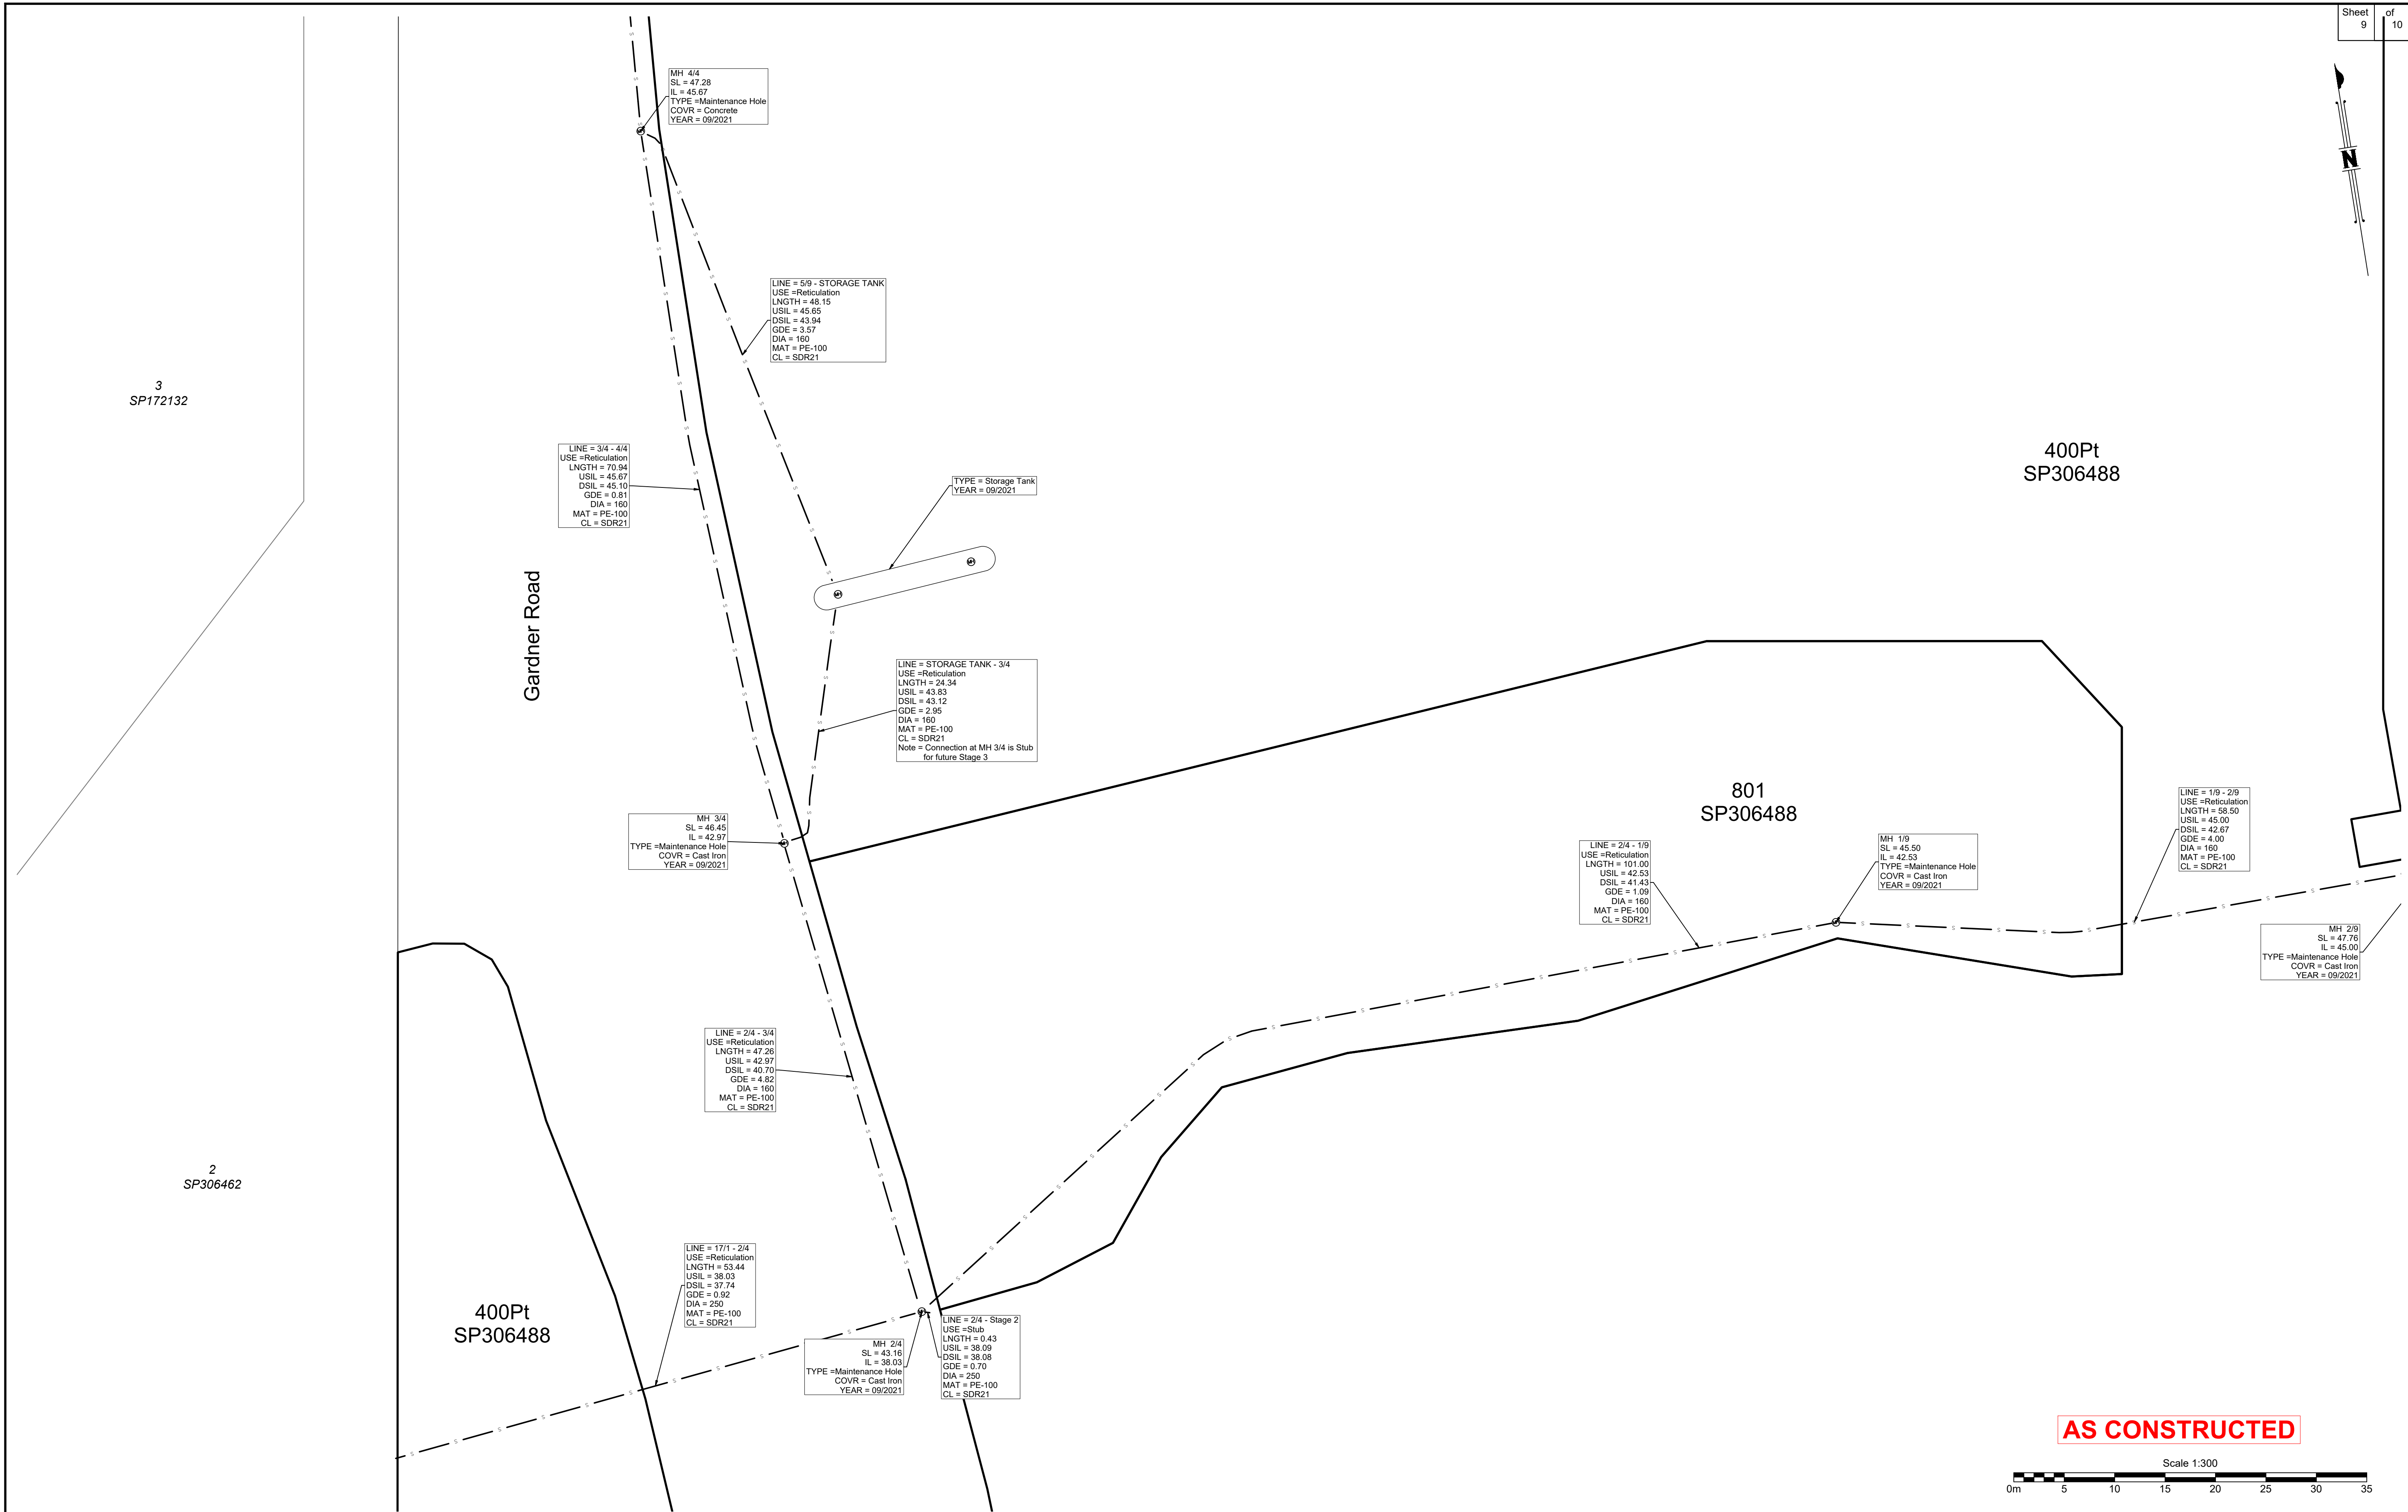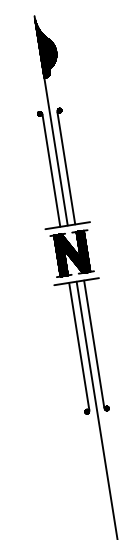

AS CONSTRUCTED

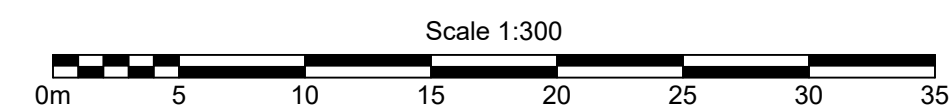

B.B.H PTY. LTD ABN 010 427 531
(trading as Bennett and Bennett Group) hereby certify
that the vertical and horizontal locations, and
dimensions shown on this plan are a true and
correct record of the As Constructed information.

Director
Cadastral Surveyor
Date 14/09/2022

I,
hereby certify that the As Constructed
information shown on this plan is a true and
correct record of sizes, types, materials,
classes etc, and it corresponds with the
relevant approved Engineering Drawings

Signed

RPEQ No. Date



Revisions


Rev	Description	Date	Initial
A	ORIGINAL	3/11/21	NCR
B	Engineers Amendments	3/03/22	NCR
C	Engineers Amendments	12/09/22	NCR

SEWER - AS CONSTRUCTED

309 Priestdale Road
Rosedale
QLD, 4123


Client: R&F Property Australia Pty Ltd
Job No: 160025
Authority: Brisbane City Council
Plan No: 160025_033_ASC.pdf
DWG File: 160025_033_ASC.dwg
Level Origin & Datum: 71.303 AHD
1:300 @ A1 Drawn: GW
Date: 12/09/22

BENNETT + BENNETT
PO Box 5021, GCMC QLD 9726
Ph: (07) 5631 8000
mail@bennettandbennett.com.au
www.bennettandbennett.com.au

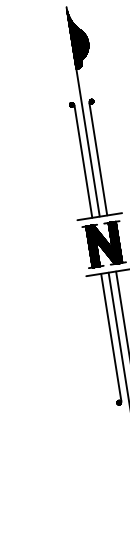

8
RP812764

7
RP812764

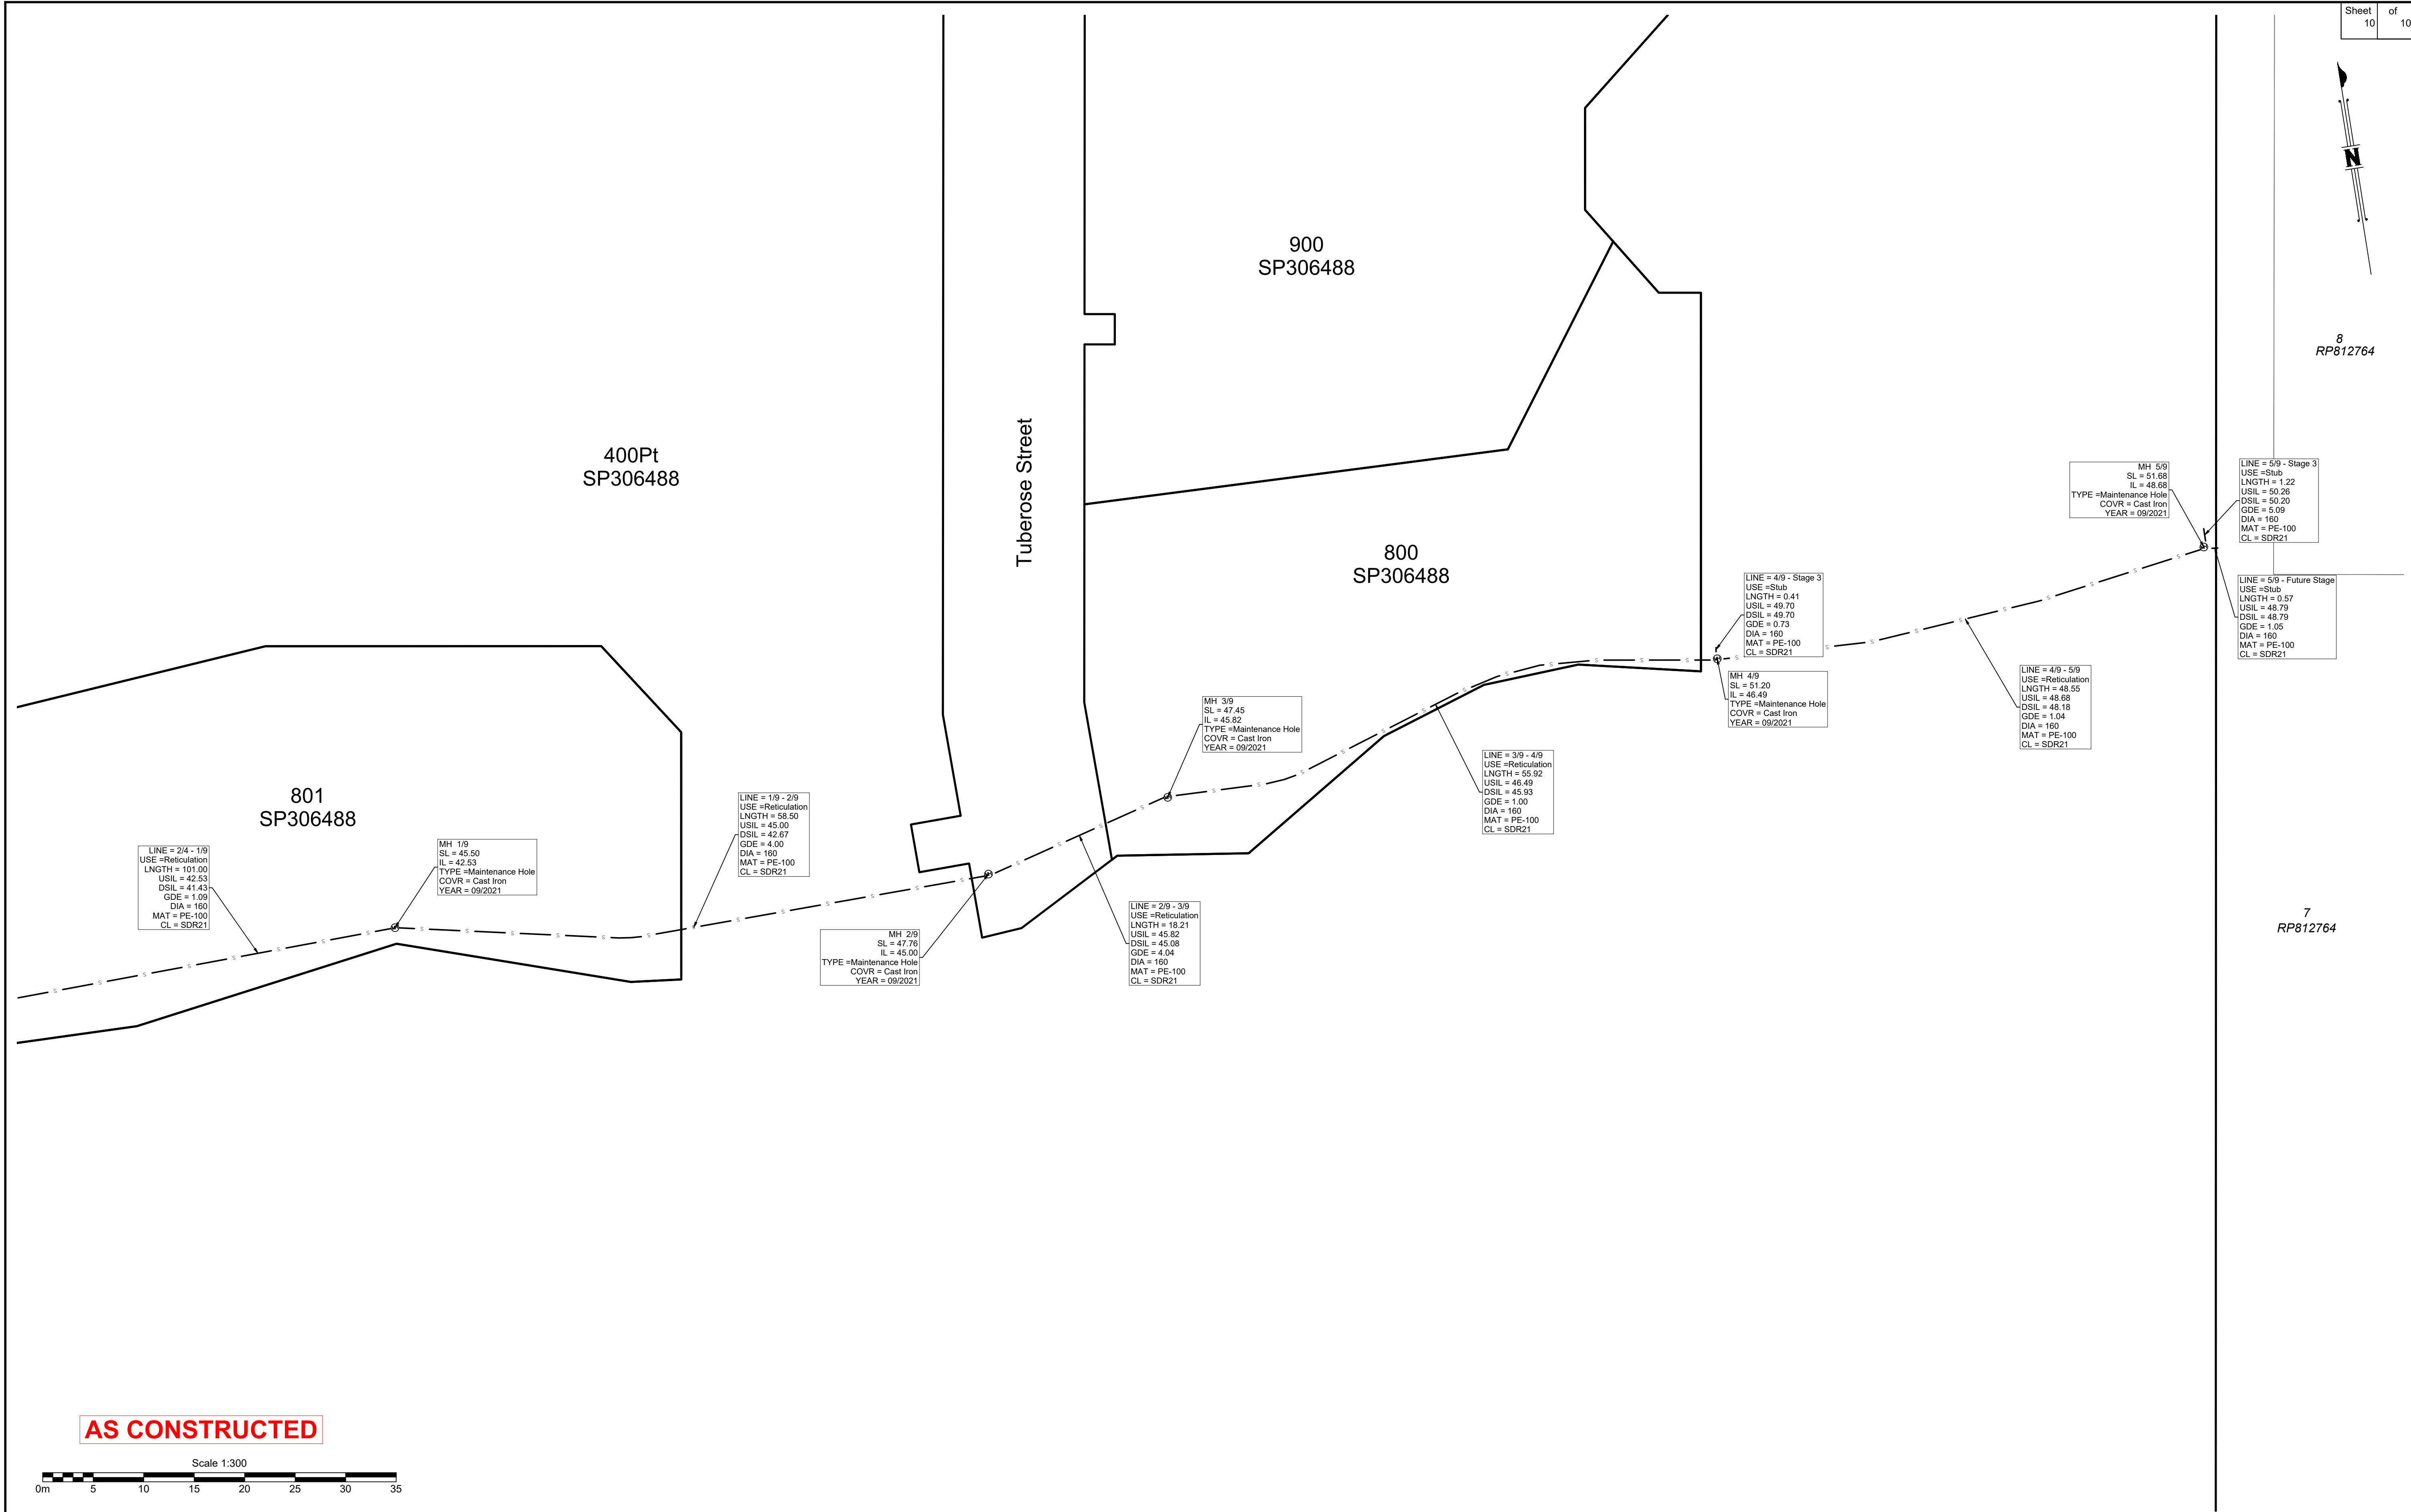

B.B.H PTY. LTD ABN 010 427 531
(trading as Bennett and Bennett Group) hereby certify
that the vertical and horizontal locations, and
dimensions shown on this plan are a true and
correct record of the As Constructed information.

[Signature]
Director
Cadastral Surveyor
Date 14/09/2022

[Signature]
Director
COMMON SEAL
Date 14/09/2022

I,
hereby certify that the As Constructed
information shown on this plan is a true and
correct record of sizes, types, materials,
classes etc, and it corresponds with the
relevant approved Engineering Drawings

Signed
RPEQ No. Date



Revisions			
Rev	Description	Date	Initial
A	ORIGINAL	3/11/21	NCR
B	Engineers Amendments	3/03/22	NCR
C	Engineers Amendments	12/09/22	NCR

SEWER - AS CONSTRUCTED
309 Priestdale Road
Rosedale
QLD, 4123

Client:	R&F Property Australia Pty Ltd		
Job No:	160025		
Authority:	Brisbane City Council		
Plan No:	160025_033_ASC.pdf		
DWG File:	160025_033_ASC.dwg		
Level Origin & Datum:	PSM180546	71.303	AHD
1:300 @ A1	Drawn:	GW	
Date:	12/09/22		

BENNETT + BENNETT
PO Box 5021, GCMC QLD 9726
Ph: (07) 5631 8000
mail@bennettandbennett.com.au
www.bennettandbennett.com.au